


T.34S.,R.1W.,W.M.

RECEIVED

OCT 08 1999

WATER RESOURCES DEPT.
SALEM, OREGON

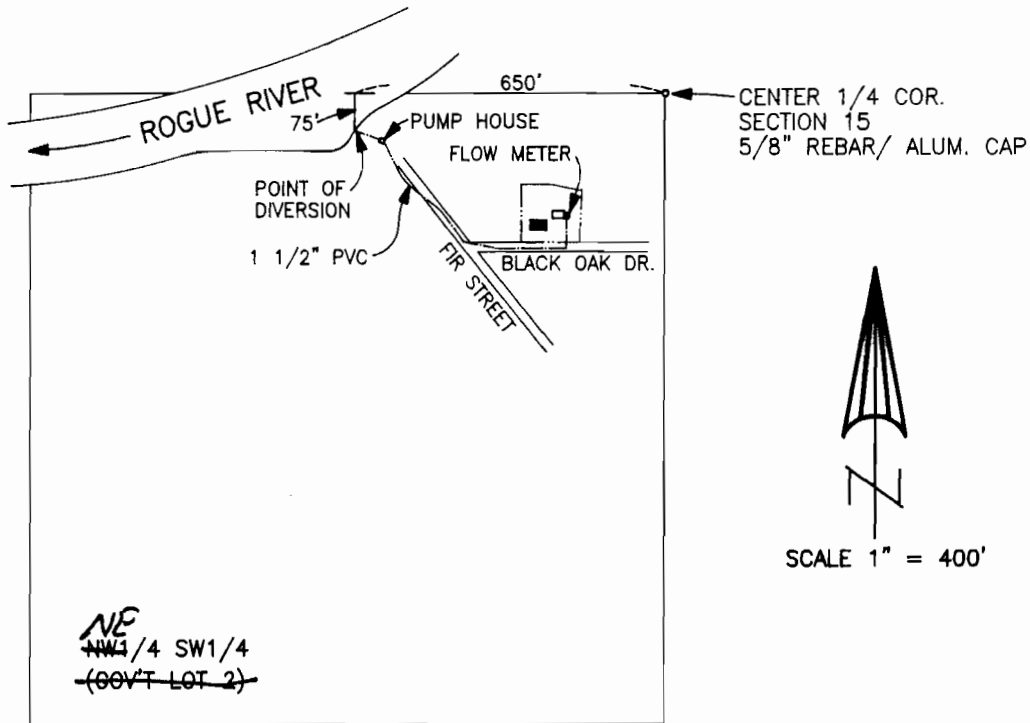


Map amended by WRO Staff, 1-15-2009
TWG

NOTE: MAP PREPARED FOR WATER RIGHT PURPOSES ONLY, NOT FOR PROPERTY BOUNDARY LOCATIONS.

FINAL PROOF MAP

APPLICATION No. S-74397
PERMIT No. 52514

IN THE NAME OF
STEVE COCHRAN

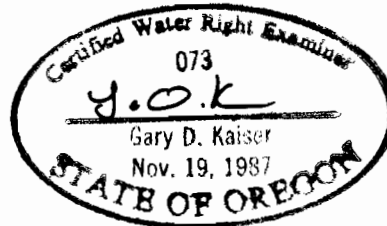

MAP PREPARED SEPTEMBER 29, 1999 BY GARY D. KAISER