


Township

Range 13 East W.M.

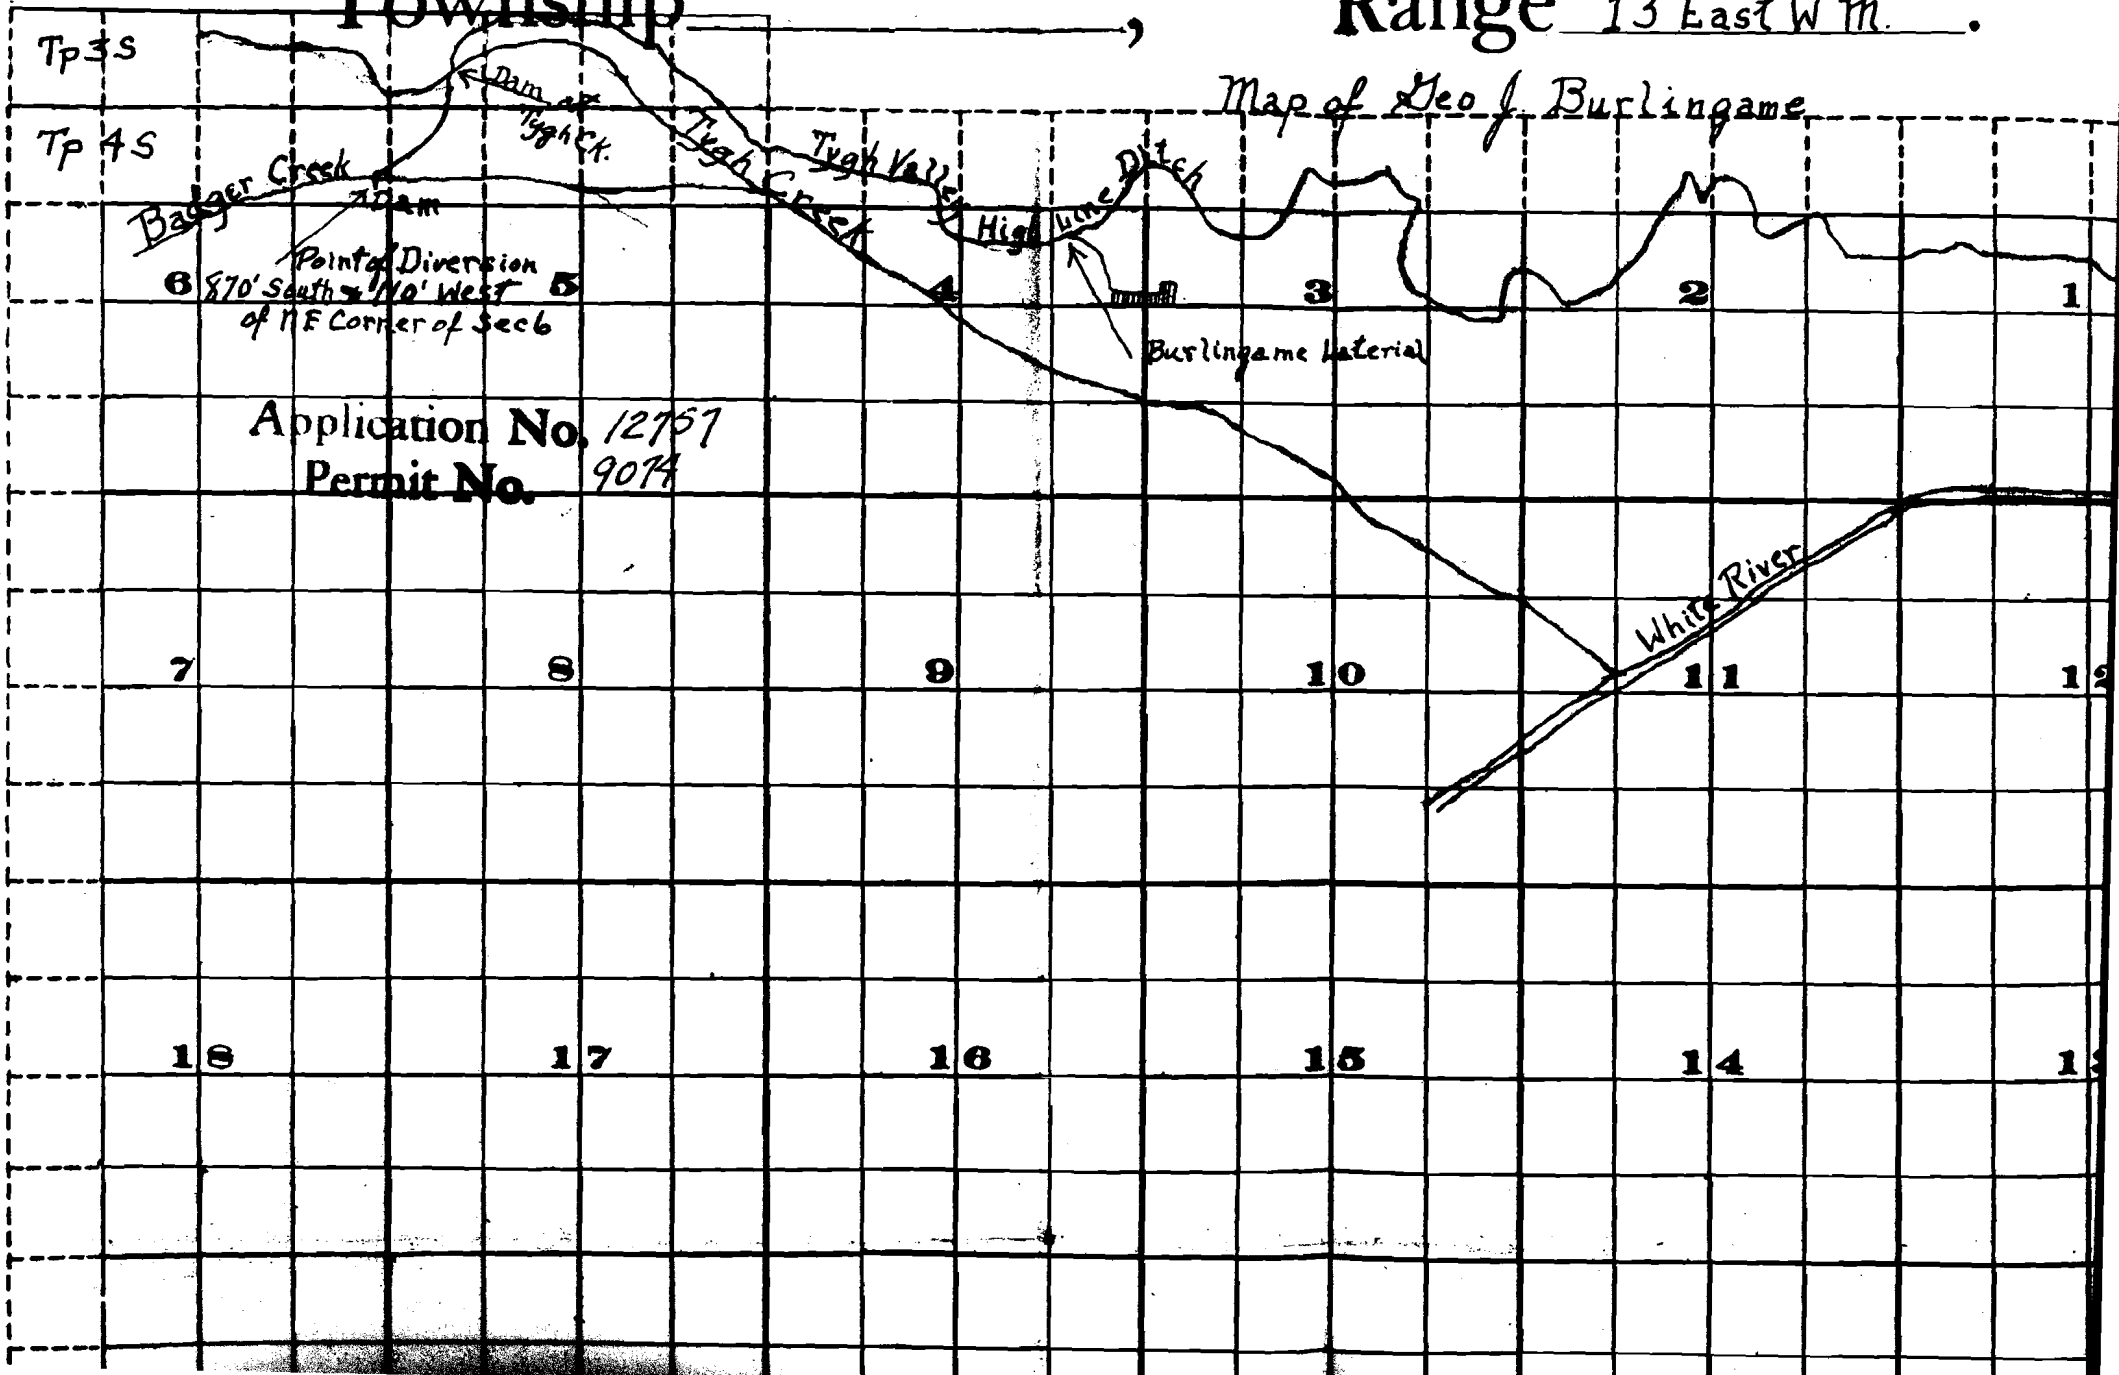

Tp 3 S

Tp 4 S

Point of Diversion  
870' South 1/4 West  
of NE Corner of Sec 6

Application No. 12757  
Permit No. 9074

Map of Geo. J. Burlingame

Burlingame Material

White River

7

8

9

10

11

12

13

17

16

15

14

13