


T.35S.R.4W.W.M.

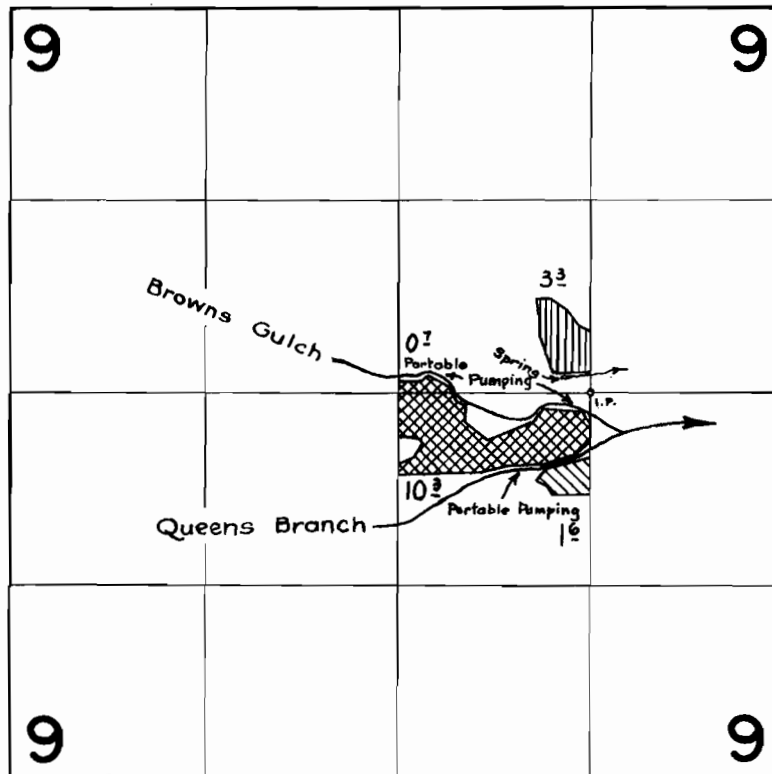

Irrigated from Spring



Irrigated from Queens Branch



Irrigated from Browns Gulch

FINAL PROOF SURVEY
UNDER

Application No. 25904.. Permit No. 20323..
IN NAME OF

NEIL MOORE

Surveyed April 17 1961, by