


FINAL PROOF MAP T-8964
 NE1/4NE1/4, SE1/4NE1/4
 SEC. 10, T.39S., R.3W., W.M.
 JACKSON COUNTY, OREGON
 FOR
 WILLIAM JAMES AND LORI McTAGGART
 495 LITTLE APPLGATE ROAD
 JACKSONVILLE, OREGON 97530

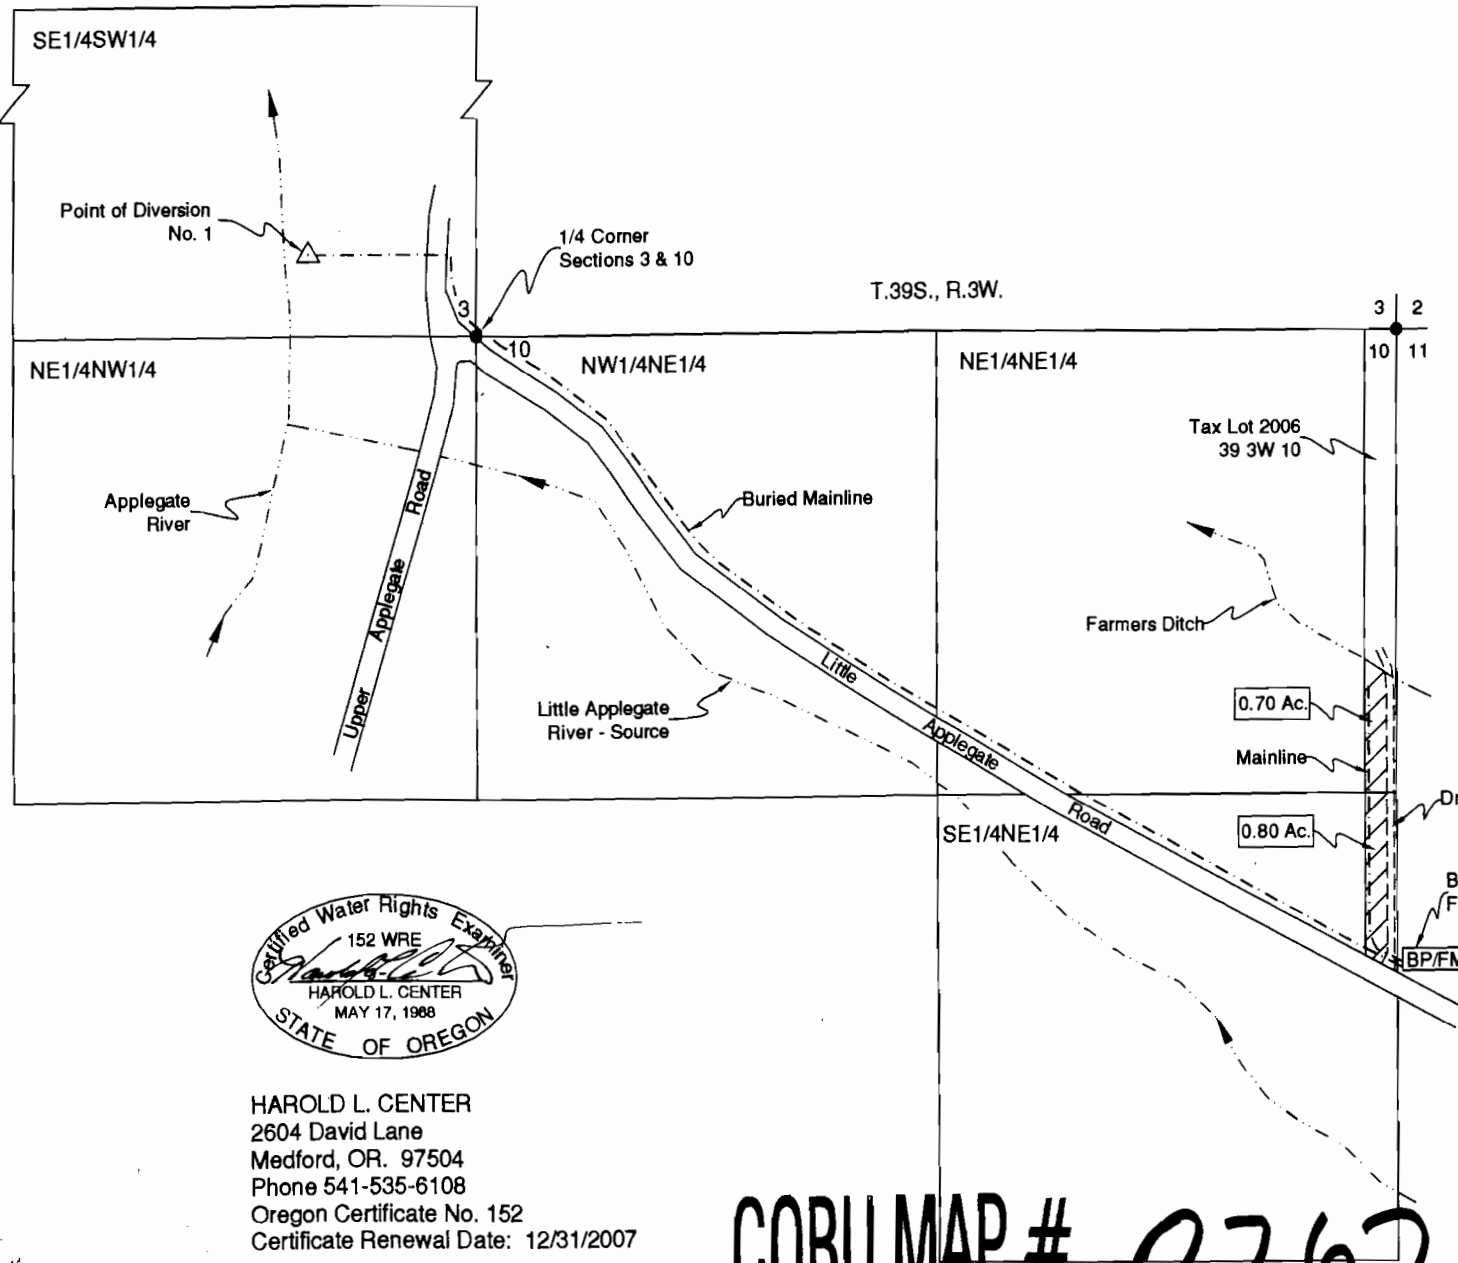

Scale: 1"=400'
 Date: July 19, 2006

- LEGEND**
- Found Survey Monument
 - === Denotes Driveway
 - - - Denotes Mainline Pipe
 - BP/FM Denotes Booster Pump & Flow Meter
 - [Hatched Box] Denotes Area Under Special Order Volume 61, Pages 421-423, Priority Date 1854

Point of Diversion No. 1 - Situated 480' West and 230' North of South One-Quarter Corner, Section 3. Fish Screen at Point of Diversion.

This map was prepared for the purpose of identifying the location of a water right only and is not intended to provide legal dimensions or location of property ownership.



HAROLD L. CENTER
 2604 David Lane
 Medford, OR. 97504
 Phone 541-535-6108
 Oregon Certificate No. 152
 Certificate Renewal Date: 12/31/2007

COBU MAP # 0262

RECEIVED

MAY 09 2006

WATER RESOURCES DIVISION
 SALEM, OREGON