

4927

FINAL PROOF MAP
 Section 33, T.38S, R.3W, W.M. Jackson County, Oregon
 File T-8937



IN NAME OF:

STONE FAMILY FARM, LLC
 900 HAMILTON ROAD
 JACKSONVILLE, OR 97530

PREPARED BY:


L.J. FRANK & ASSOCIATES, P.C.
 CONSULTING LAND SURVEYORS
 815 WEST SOUTH STREET
 MEDFORD, OR 97501
 PHONE: (541) 772-3785
 EMAIL: LFRANK@CHARTER.NET

LEGEND:

-  - ACRE PER CERT. 1838, 8072 & 8073 & 8080 UNDER THIS TRANSFER
-  - ACRE PER CERT. 1838, 8072 & 8073 & 8080, NOT UNDER THIS TRANSFER



RECEIVED

JUL 22 2009
 WATER RESOURCES DEPT
 SALEM OREGON

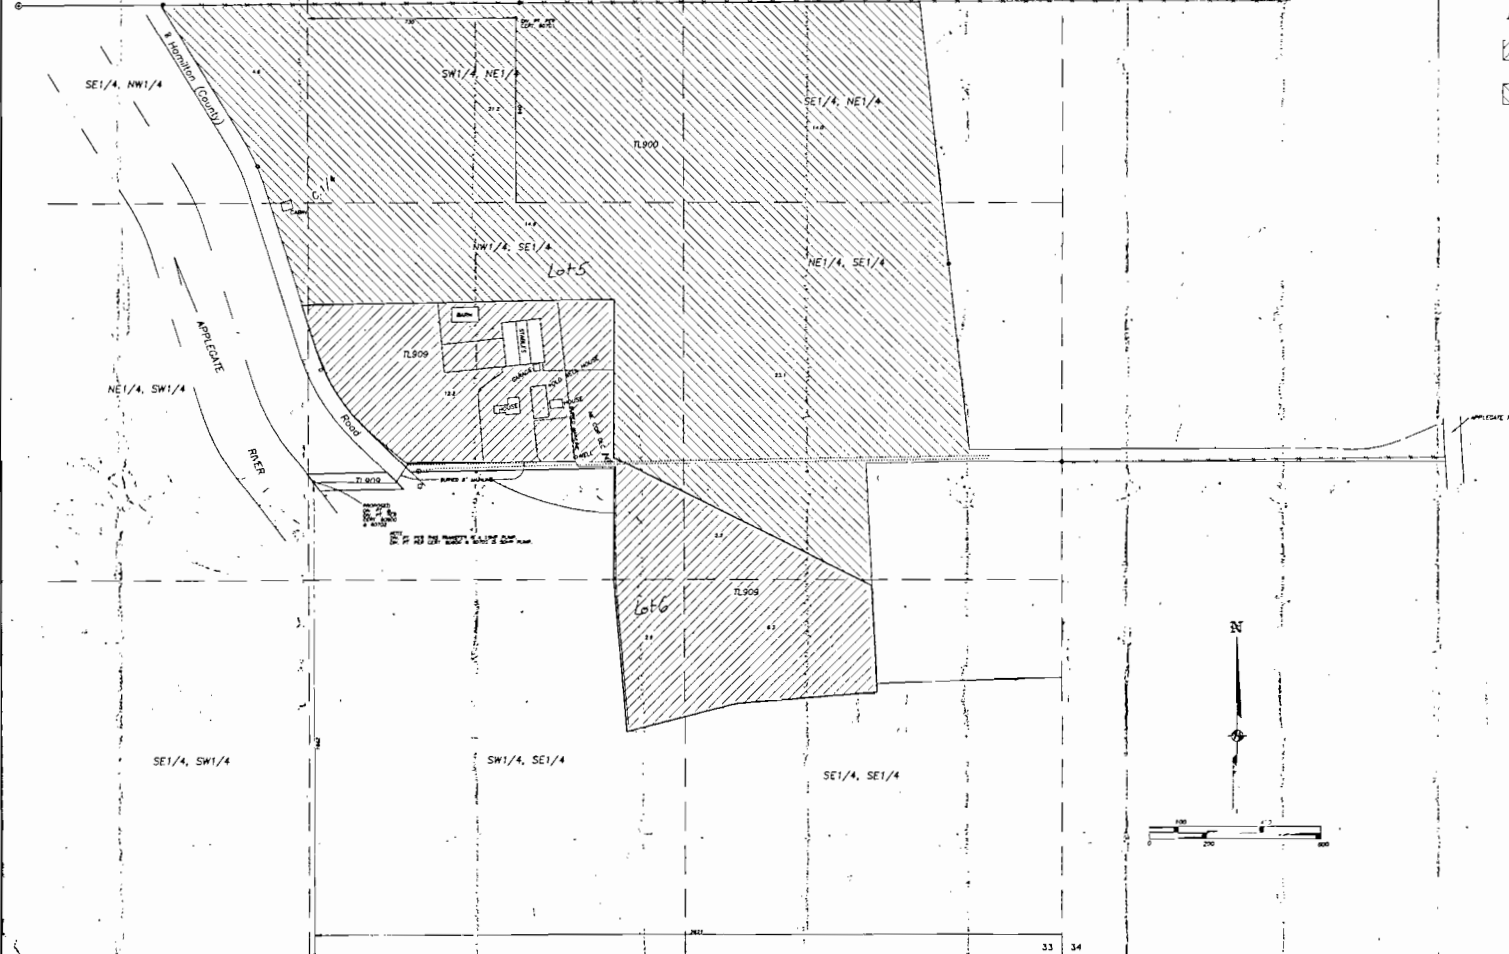

T.38S, R.3W, W.M.

SCALE 1" = 1000'

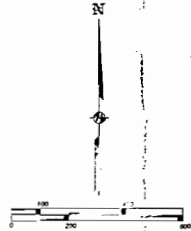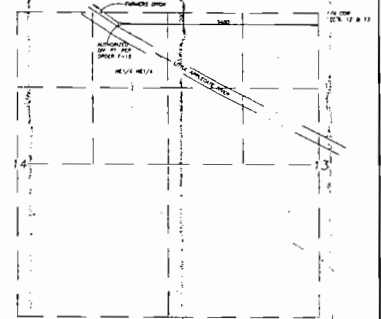

COBU MAP # 0140

38.3W33 T.3S 900 & 909


Cor lots added to map 6/12/2009



FINAL PROOF MAP	DATE	FILE
SECTION 33, T.38S, R.3W	7/22/09	1838, 8072, 8073, 8080
FOR: STONE FAMILY FARM, LLC	PREPARED BY:	L.J. FRANK & ASSOCIATES, P.C.

