


T. 1 N., R. 10 E., W.M.

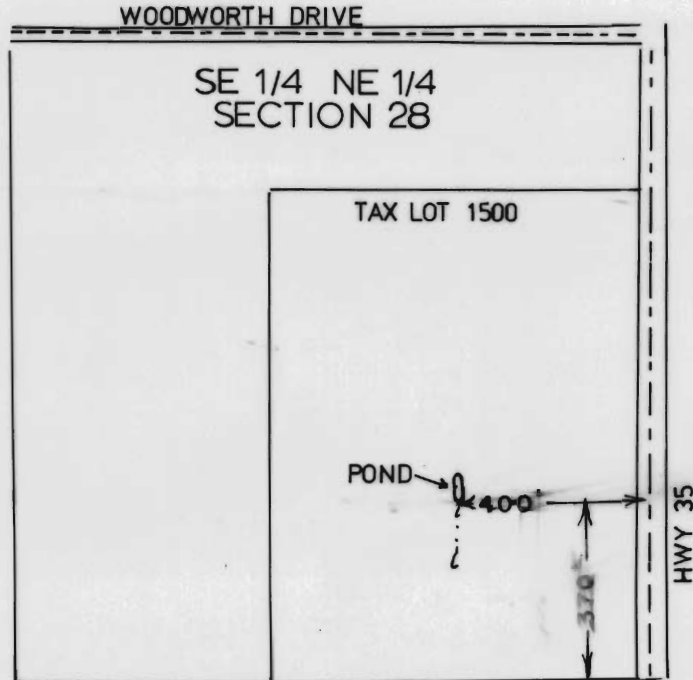

1" = 400'

FINAL PROOF SURVEY
UNDER

Application No. R-56121 Permit No. R-6628
IN NAME OF

JACK W. AND JUDY A. SOUTHARD

Surveyed OCTOBER 8, 1992, by J. MILLER