

SECTION 1, T.25., R.3W., W.M.
WASHINGTON COUNTY OREGON



26 31
1 6



SCALE: 1" = 400'

MAP BASE:
ASSESSORS MAP &
WAC PHOTO

PREPARATION OF THIS MAP IS FOR THE
PURPOSE OF IDENTIFYING THE LOCATION OF
THE WATER RIGHT ONLY. THERE IS NO INTENT
TO PROVIDE DIMENSIONS OR LOCATION OF
PROPERTY OWNERSHIP LINES.

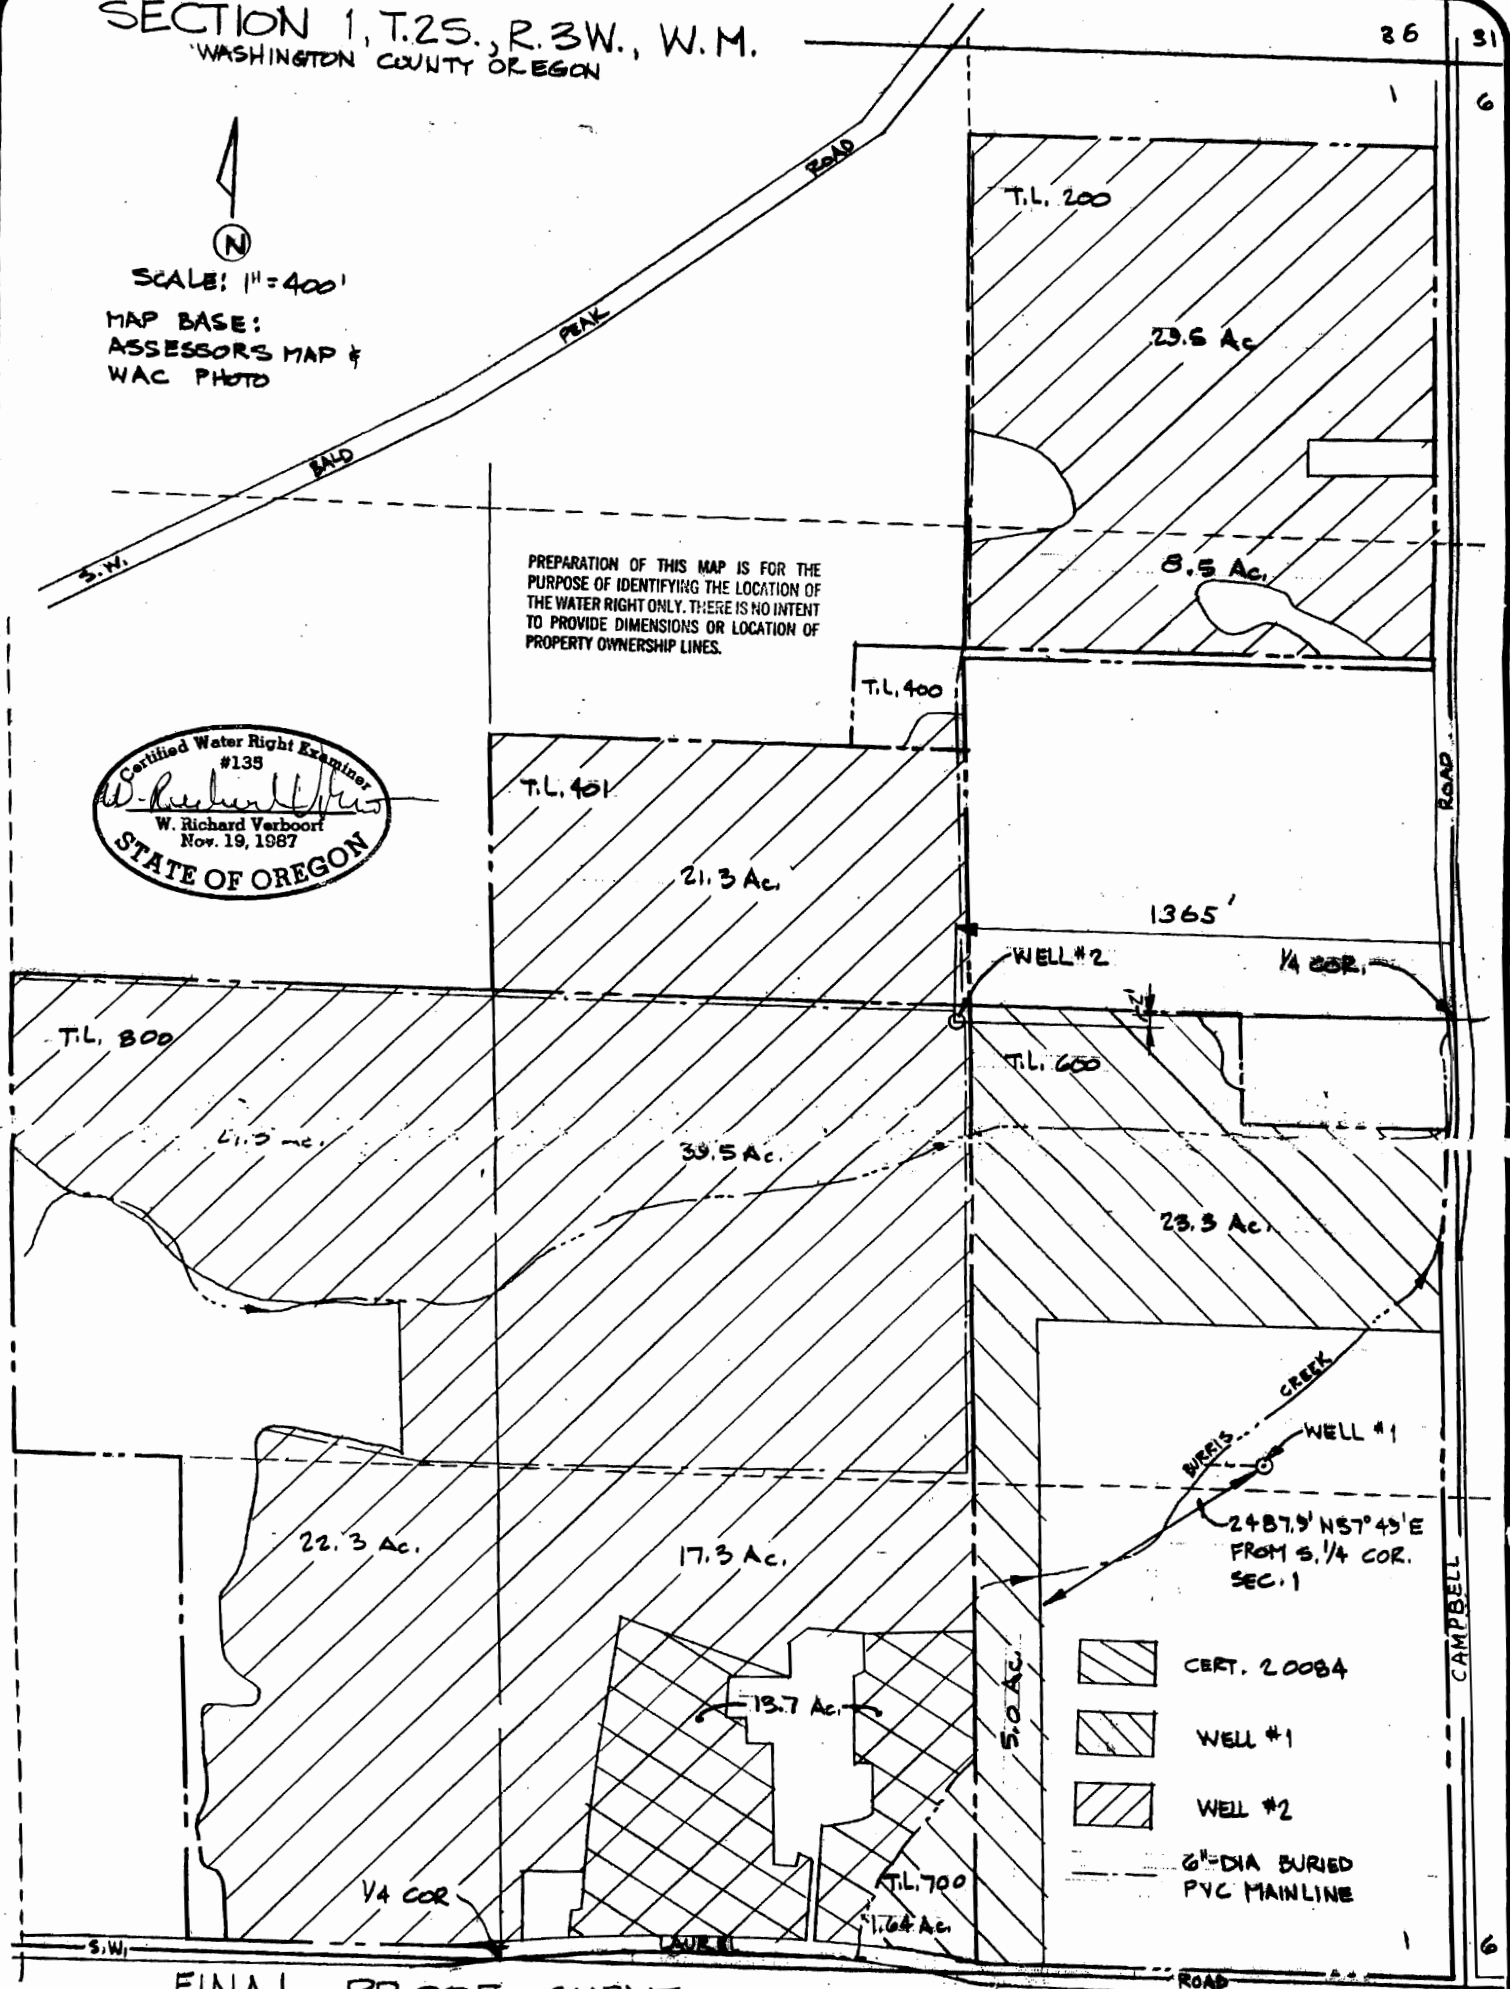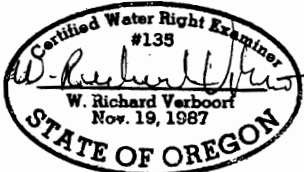

FINAL PROOF SURVEY

SURVEYED AUGUST 24, 1994 PERMIT G-11118

12 7

VERBOORT ENGINEERING
AGRICULTURE • CIVIL • WATER RESOURCES
HILLSBORO, OREGON

	by	date
designed	WRV	8/31/94
drawn	JER	8/31/94
checked	WRV	8/31/94
drawing no.	94-B-15	
sheet no.	1/1	

RICHARD EGGER
31181 S.W. LAUREL ROAD
HILLSBORO, OR 97125