RECEIVED
APR 03 1997
WATER RESOURCES DEPT.
SALEM, OREGON

T. 3 S. R. 4 W. W.M.

YAMHILL COUNTY

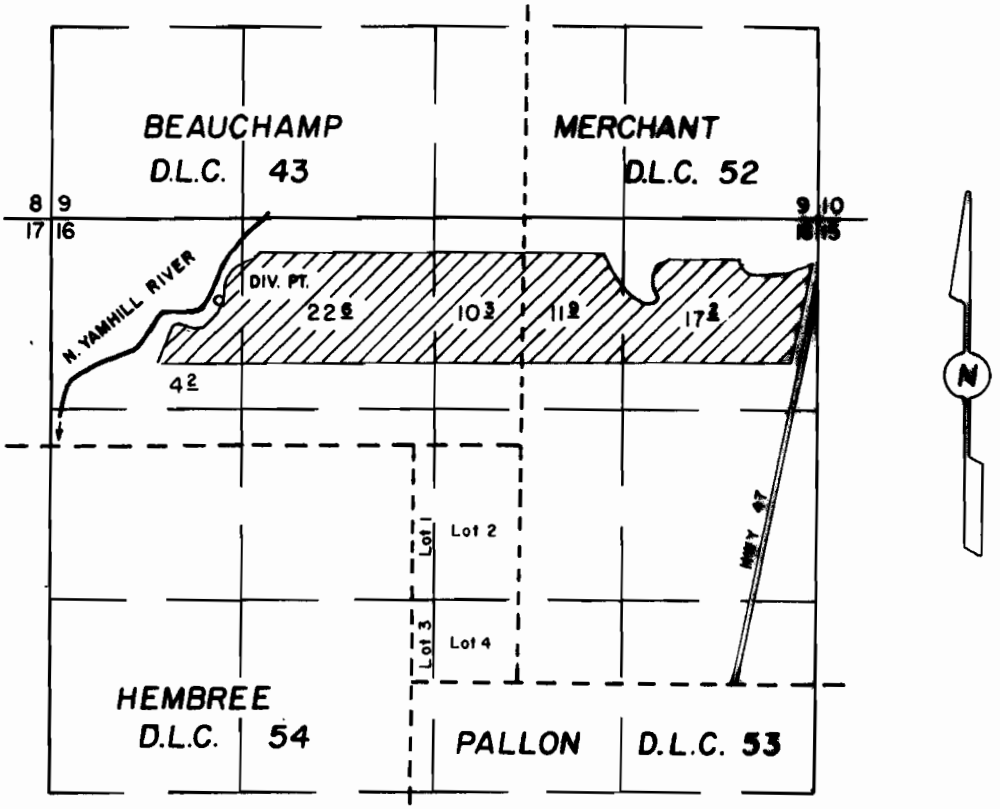

DIV. PT. LOCATION: 960'N & 1440'W OF NE COR. W. C. HEMBREE D.L.C. No. 54

FINAL PROOF SURVEY

UNDER

Application No. 56375 / 70212 Permit No. 42306 / 51847

IN THE NAME OF

BAILEY NURSERIES INC.

SURVEYED September 12, 1996

Scale: 1" = 1320'

NOTE: This map is for the purpose of identifying the location of water rights and has no intent to dimension or locate property ownership lines.

STATE OF OREGON
May 30, 1997