



COBU MAP 0407

EAGLE CREST DESTINATION RESORT
WATER RIGHTS MAP
FINAL PROOF SURVEY
JUNE, 2004
(UPDATED JULY, 2008)
LOCATED WITHIN TOWNSHIP 15 SOUTH, RANGE 12 EAST, W.M.

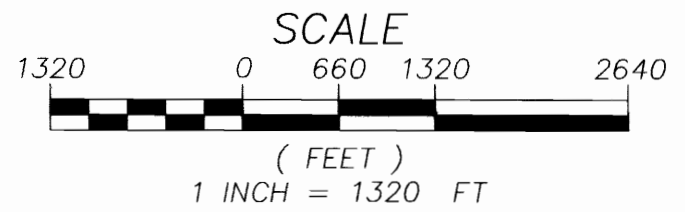

NOTE: THIS MAP WAS PREPARED FOR THE PURPOSE OF IDENTIFYING THE LOCATION OF WATER RIGHTS. THIS MAP IS NOT INTENDED TO PROVIDE DIMENSIONS OR THE LOCATION OF PROPERTY OWNERSHIP LINES.

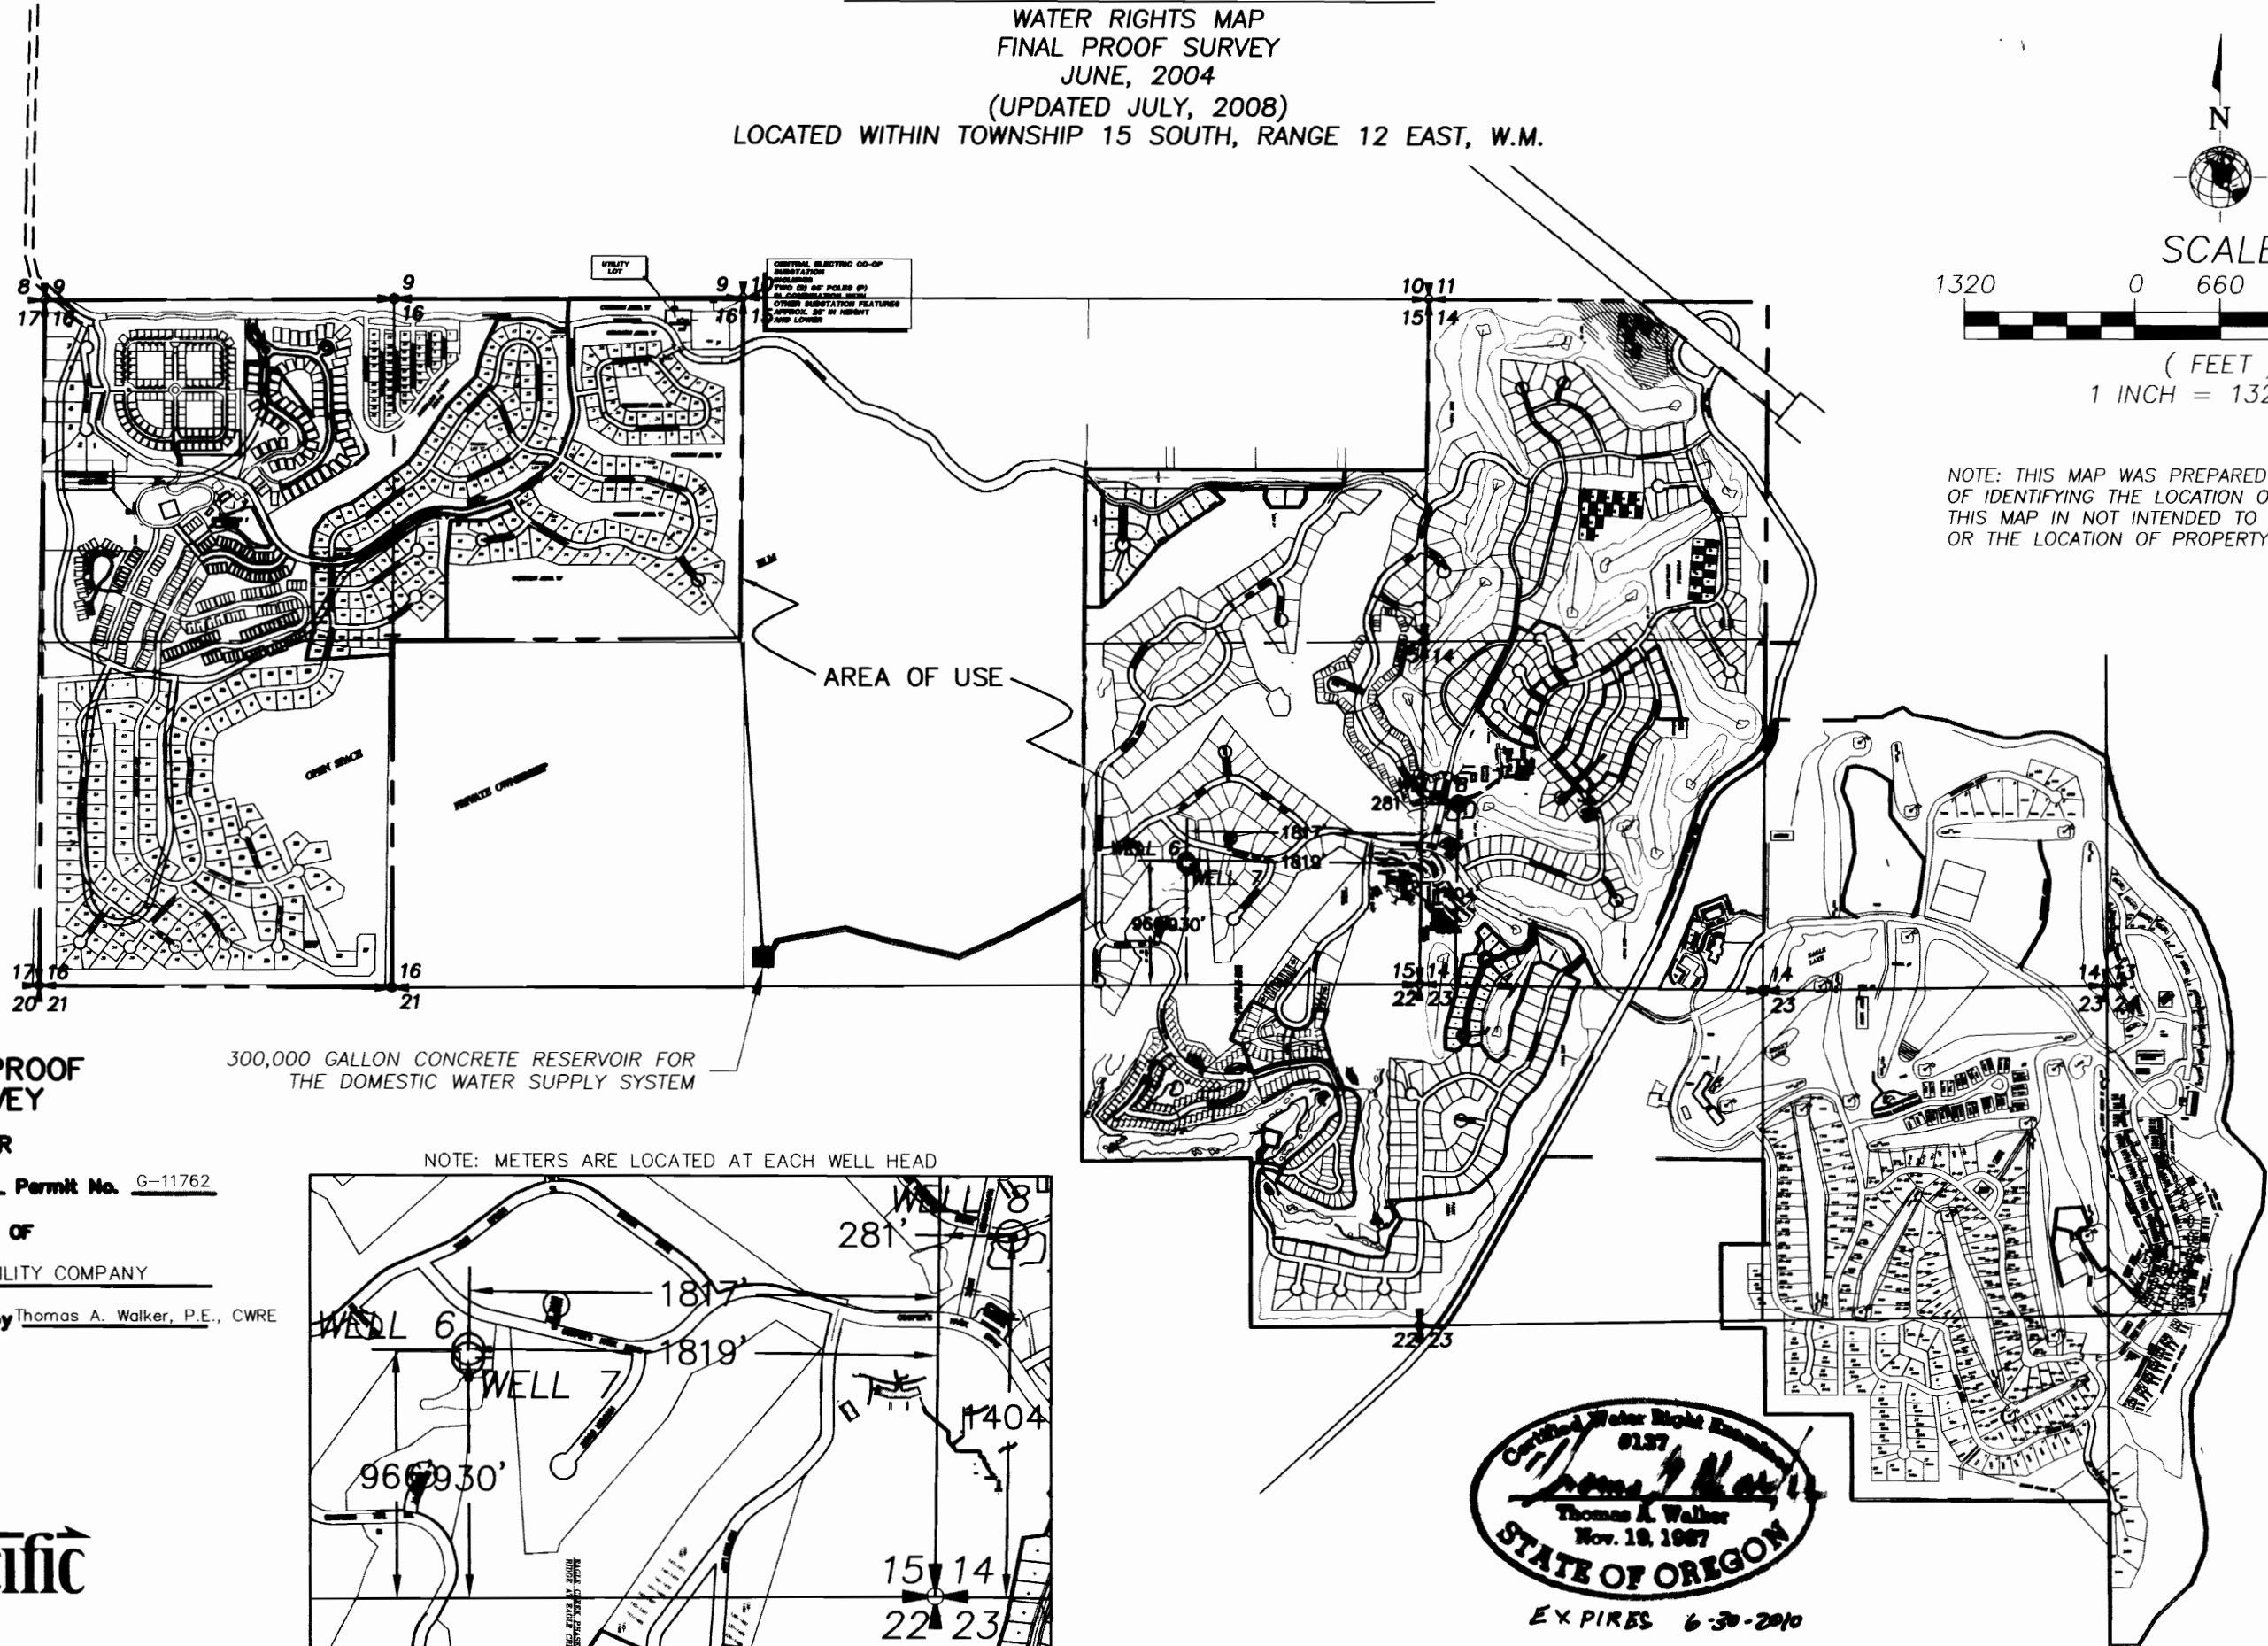

FINAL PROOF SURVEY

300,000 GALLON CONCRETE RESERVOIR FOR THE DOMESTIC WATER SUPPLY SYSTEM

UNDER
Application No. G-12905 Permit No. G-11762


IN NAME OF
CLINE BUTTE UTILITY COMPANY

Surveyed JUNE, 2004, by Thomas A. Walker, P.E., CWRE
UPDATED JULY 14, 2008

7/14/2008
EC04FPS.DWG

WHPacific

920 SW Emkay Dr
Bend, OR 97702
541-388-4255 Fax 541-388-4229
www.whpacific.com

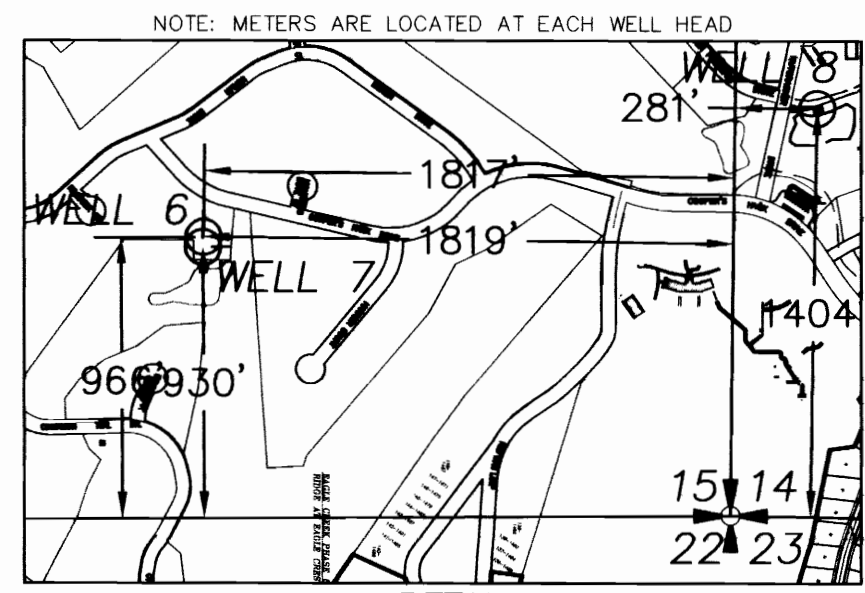

DETAIL

