


THIS MAP WAS PREPARED FOR THE PURPOSE OF IDENTIFYING THE LOCATION OF THE WATER RIGHT AND IS NOT INTENDED TO PROVIDE LEGAL DIMENSIONS OR LOCATIONS OF PROPERTY OWNERSHIP LINES.

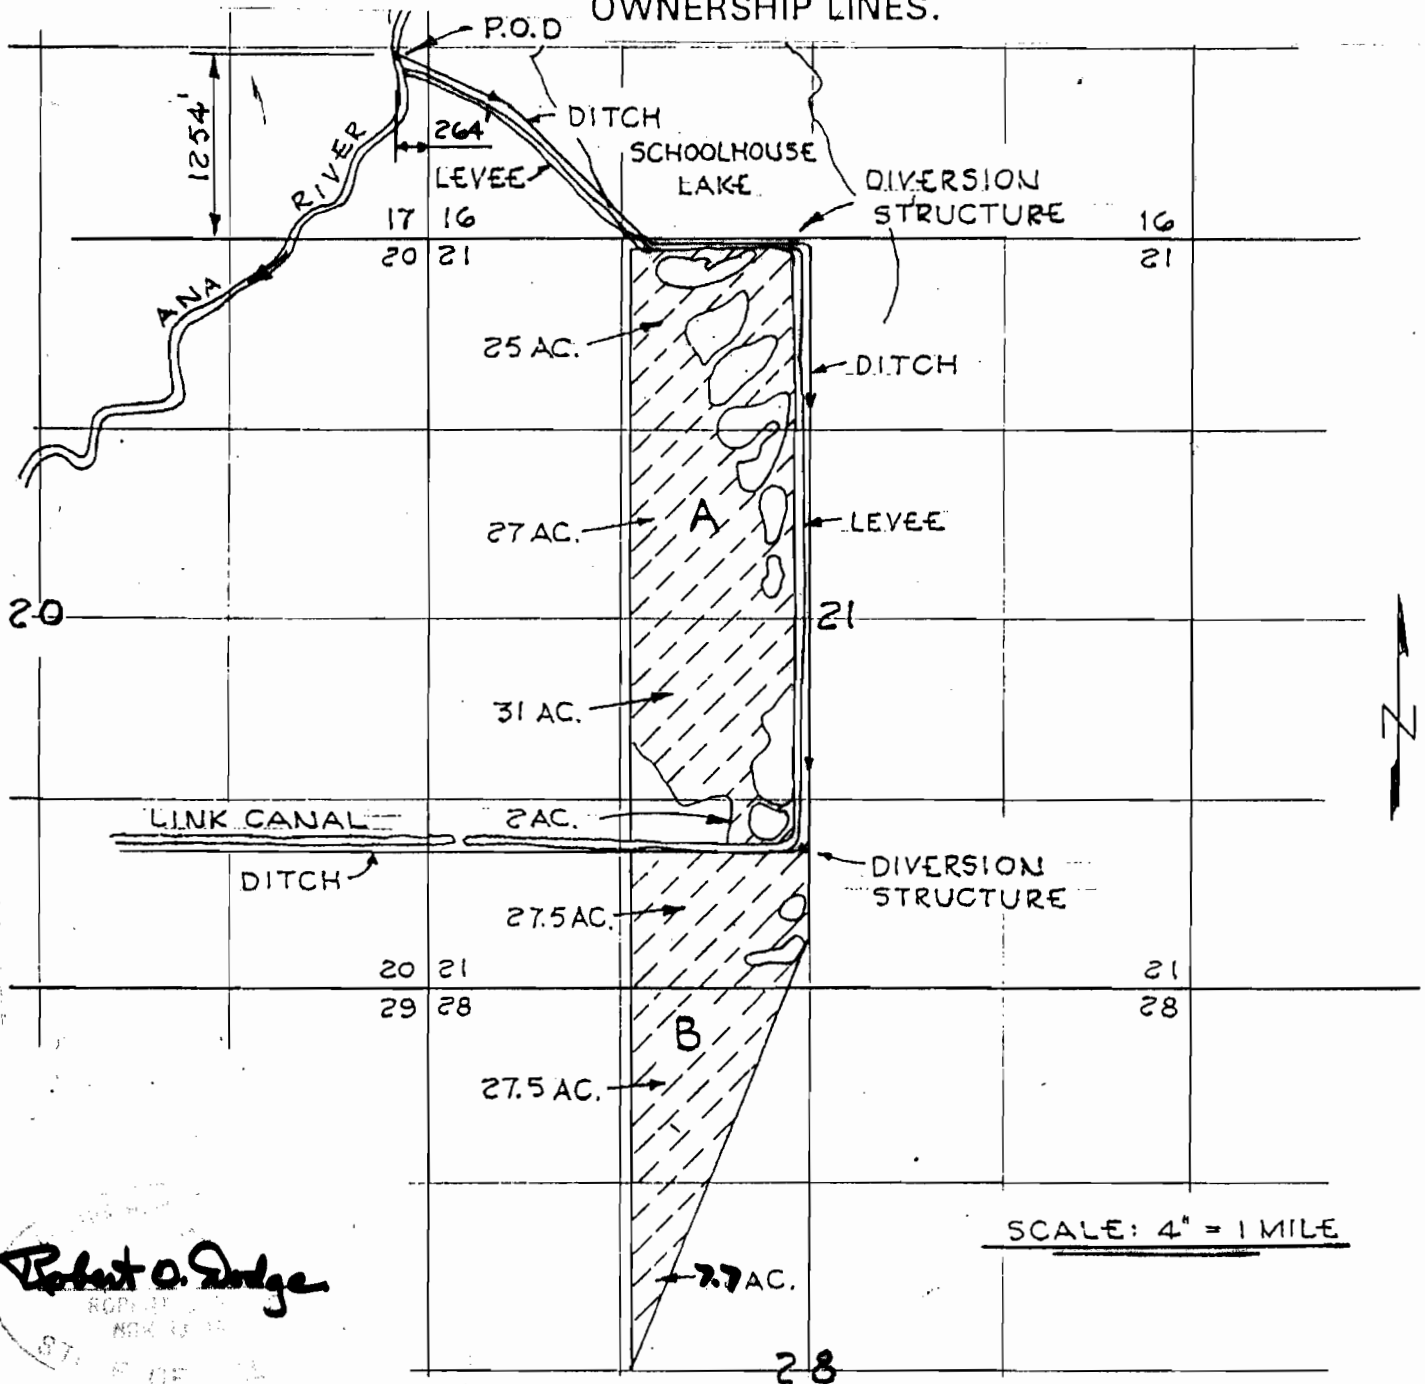

**FINAL PROOF SURVEY
UNDER**

APPLICATION NO. S-73449 PERMIT NO. 52834
IN NAME OF

OREGON DEPARTMENT OF FISH AND WILDLIFE
SURVEYED: 5/14/97 BY: DODGE

T30S; R17E