




Claim of Beneficial Use
Deborah Johnson
Transfer T-6426
Permit 53950
T 36 S, R 2 W, W.M.
Section 18

Legend

-  Prim T6426 & Sup 53950
-  S-53950 primary
-  Pipeline




0 400 Feet

RECEIVED

SEP 24 2008

WATER RESOURCES DEPT
SALEM, OREGON

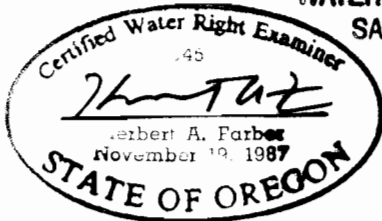

RENEWAL DATE 12-31-09

Note: This map for water right purposes only.
Not to be used for property line location.



PO Box 5286
Central Point, Oregon 97502
Phone 541-664-5599
Fax 541-664-5603
Email hafarber@charter.net

Farber & Sons, Inc.
431 Oak Street
Central Point, Oregon
Tax ID: 93-1057173