


T.6S., R.1E., W.M.

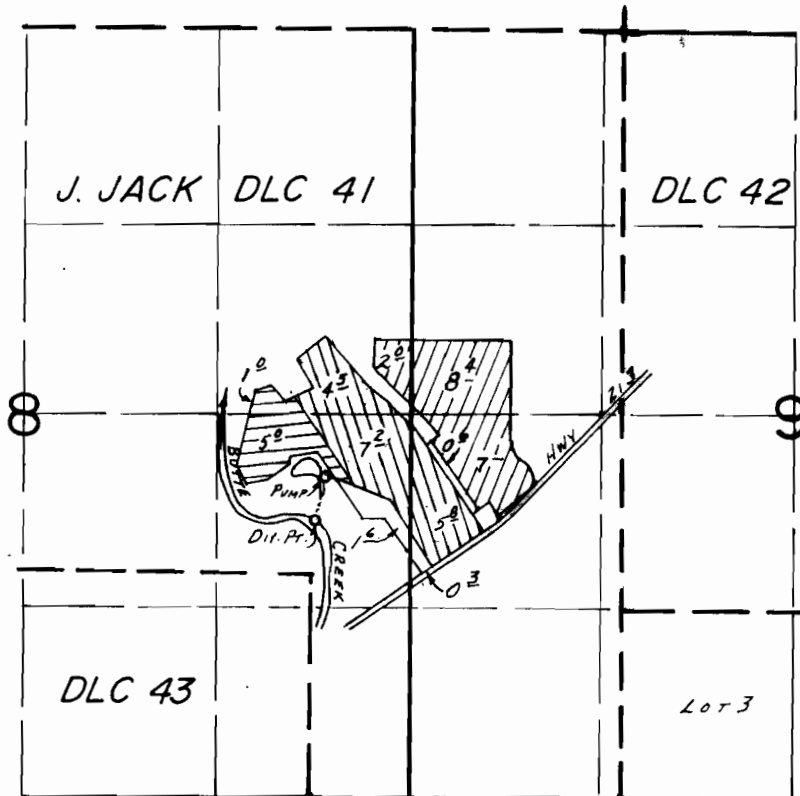


Div. Pt. Loc.: 3390'S. & 2100'W. FROM NE COR. J JACK DLC 41


SCALE: 1" = 1320'

FINAL PROOF SURVEY

UNDER

Transfer No. 5069 

Transfer No. 5504 

  Cert 17290 (not involved)

IN NAME OF

..WILBUR & DARLINE VANDERBECK

Surveyed July 23, 1984, by B.W. BISHOP
June 14, 1985, T.M. WARREN