


RECEIVED

JAN 27 2009


WATER RESOURCES DEPT
SALEM, OREGON

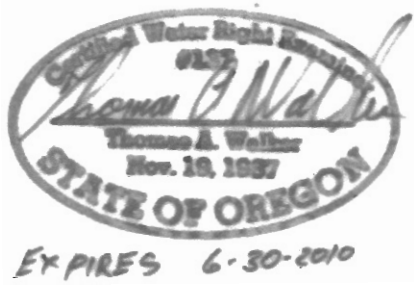

SUNRIVER WATER, LLC.
CLAIM OF BENEFICIAL USE MAP
TOWNSHIP 20 SOUTH, RANGE 11 EAST,
SECTIONS 7, 8, 17, & 18
SEPTEMBER 2008

TRANSFER APPLICATION T-9729
TOTAL IRRIGATED AREA = 100.9 ACRES
LEGEND

- EXISTING WELL LOCATION
- AREA OF USE FOR IRRIGATION WATER RIGHT C-81406
- AREA OF USE FOR IRRIGATION WATER RIGHT C-57066
- EXISTING IRRIGATION MAIN (SIZE AS INDICATED)

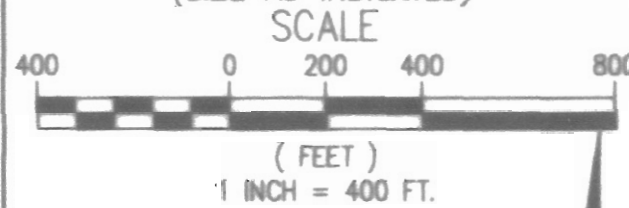

WHPacific

123 SW Columbia Street
Bend, OR 97702
541-388-4255 Fax 541-388-4229
www.whpacific.com

NOTE: THIS MAP WAS PREPARED FOR THE PURPOSE OF IDENTIFYING THE LOCATION OF WATER RIGHTS.
THIS MAP IS NOT INTENDED TO PROVIDE LEGAL DIMENSIONS OR LOCATIONS OF PROPERTY OWNERSHIP LINES.

COBU MAP # 377