


RECEIVED

JAN 27 2009


WATER RESOURCES DEPT  
SALEM, OREGON

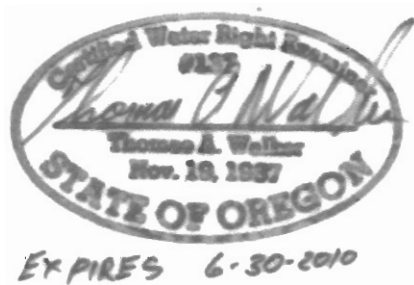

SUNRIVER WATER, LLC.  
CLAIM OF BENEFICIAL USE MAP  
TOWNSHIP 20 SOUTH, RANGE 11 EAST,  
SECTIONS 7, 8, 17, & 18  
SEPTEMBER 2008

TRANSFER APPLICATION T-9729  
TOTAL IRRIGATED AREA = 100.9 ACRES  
LEGEND

- EXISTING WELL LOCATION
- AREA OF USE FOR IRRIGATION WATER RIGHT C-81406
- AREA OF USE FOR IRRIGATION WATER RIGHT C-57066
- EXISTING IRRIGATION MAIN (SIZE AS INDICATED)

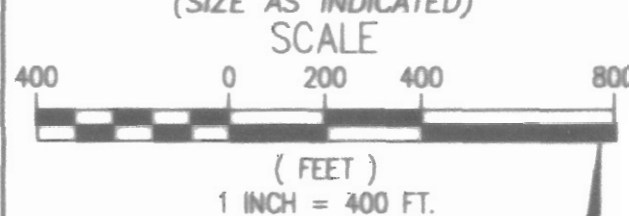

**WHPacific**

123 SW Columbia Street  
Bend, OR 97702  
541-388-4255 Fax 541-388-4229  
www.whpacific.com

NOTE: THIS MAP WAS PREPARED FOR THE PURPOSE OF IDENTIFYING THE LOCATION OF WATER RIGHTS.  
THIS MAP IS NOT INTENDED TO PROVIDE LEGAL DIMENSIONS OR LOCATIONS OF PROPERTY OWNERSHIP LINES.

**COBU MAP # 377**