


ROWANSHIRE 39 S RANGE 8 W T. W.

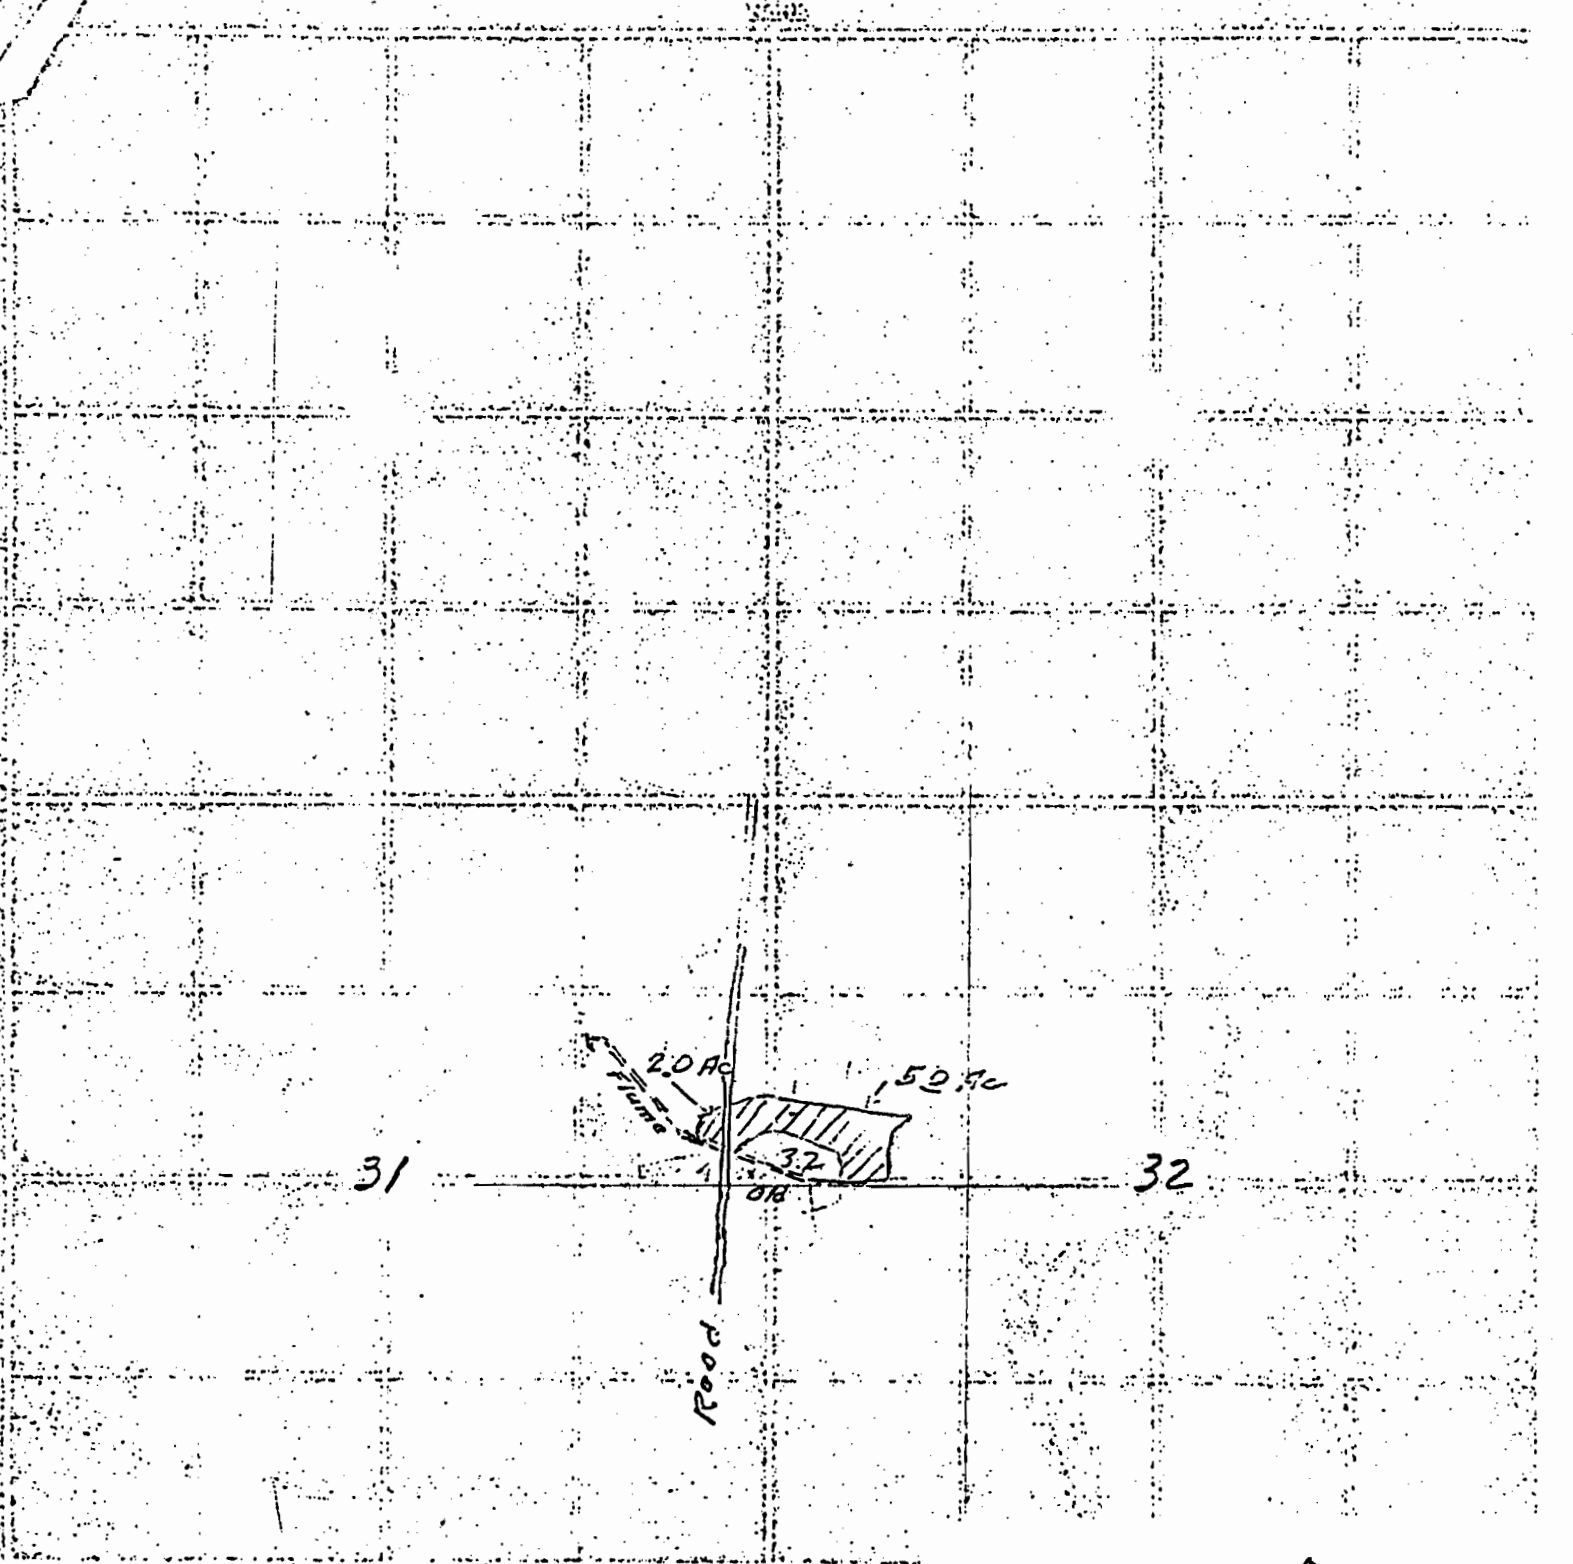

- Stohlman A  
Volume 42 page 212


(Figure 1)

FINAL PROOF  
MAP

C-15604

T 39 S, R 8 W

1" = 400'

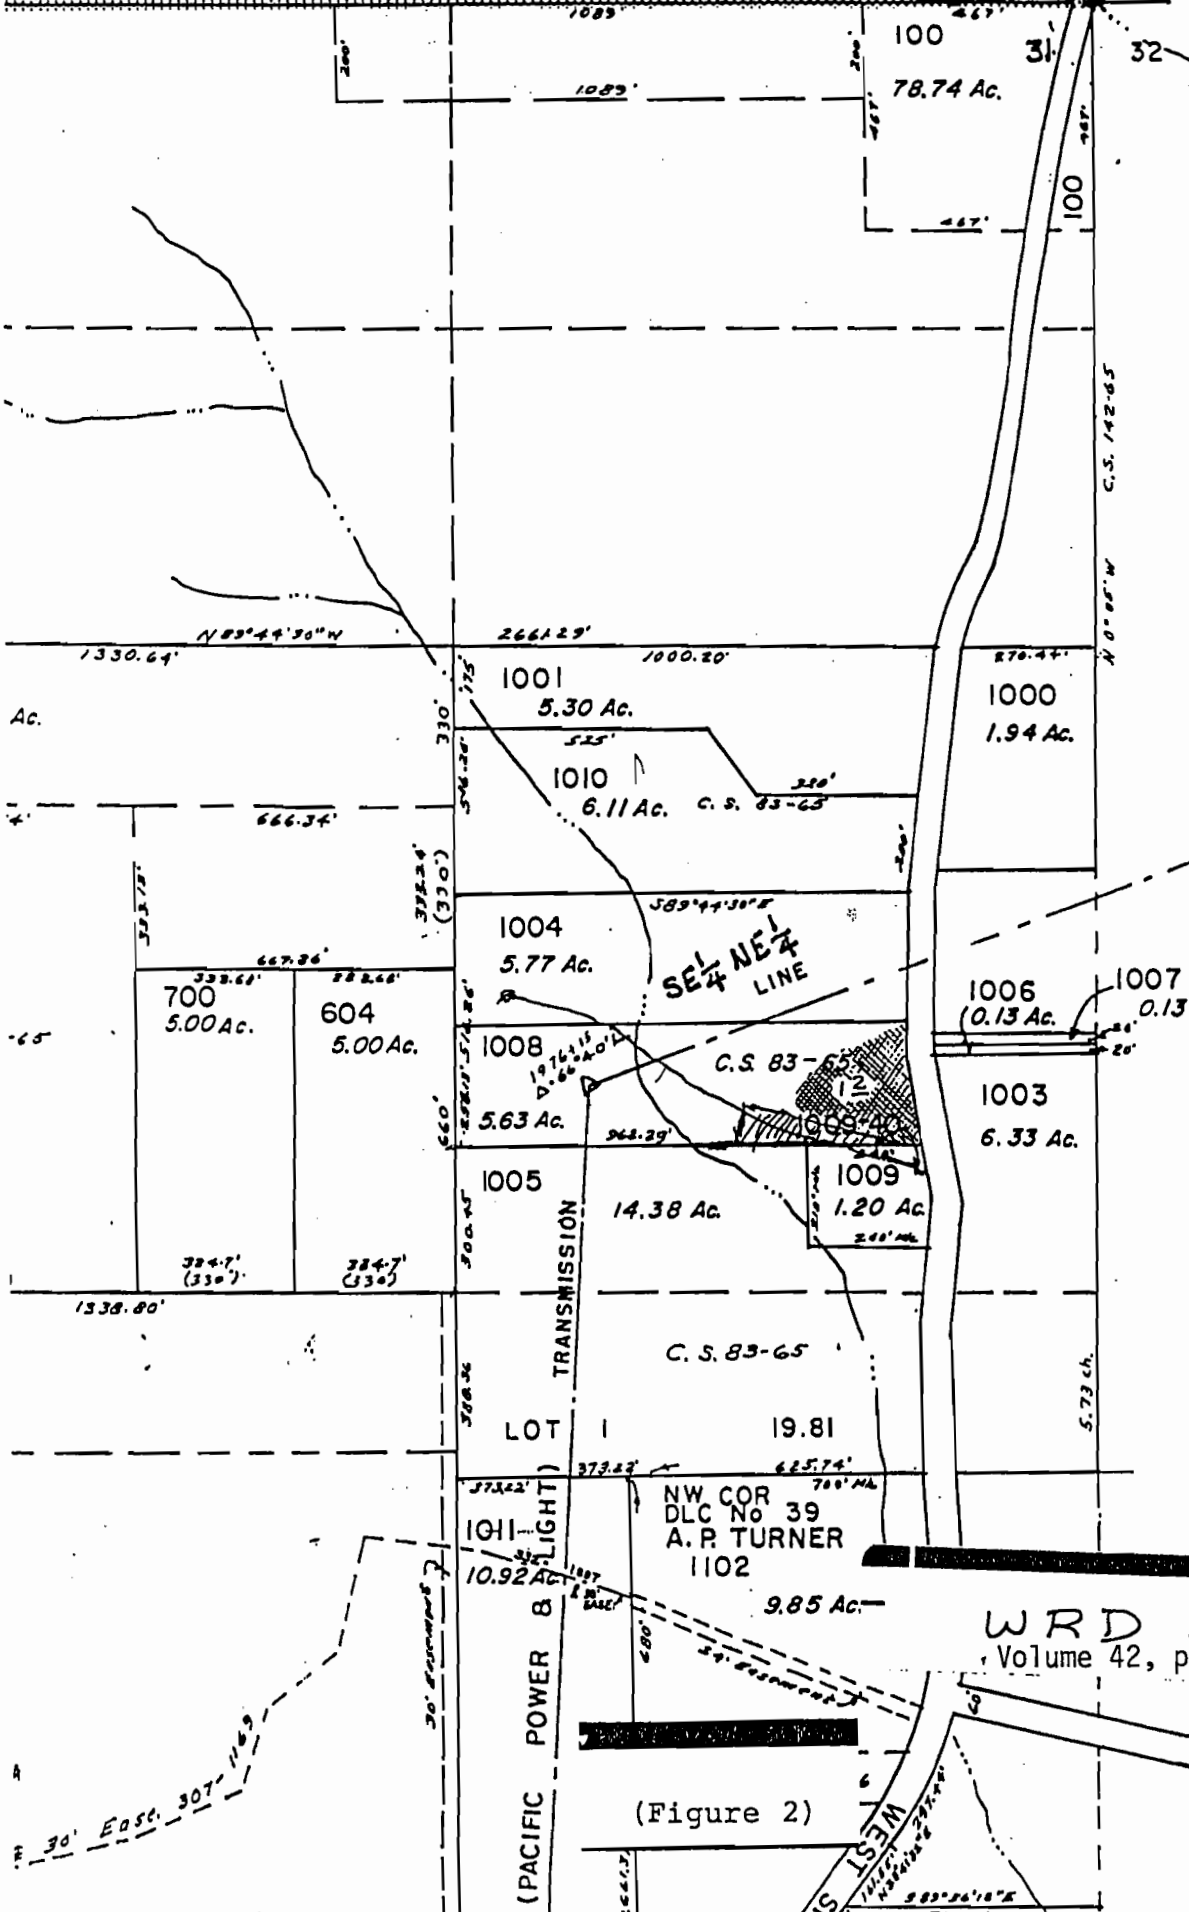

Cancelled  
 T.L. 1100  
 602  
 800  
 900  
 200  
 300  
 1104  
 1009  
 1090

SEE MAP 39 8 32

WRD 4-A  
 Volume 42, page 213

(Figure 2)