T. 6 S.R.3 W.W. M.

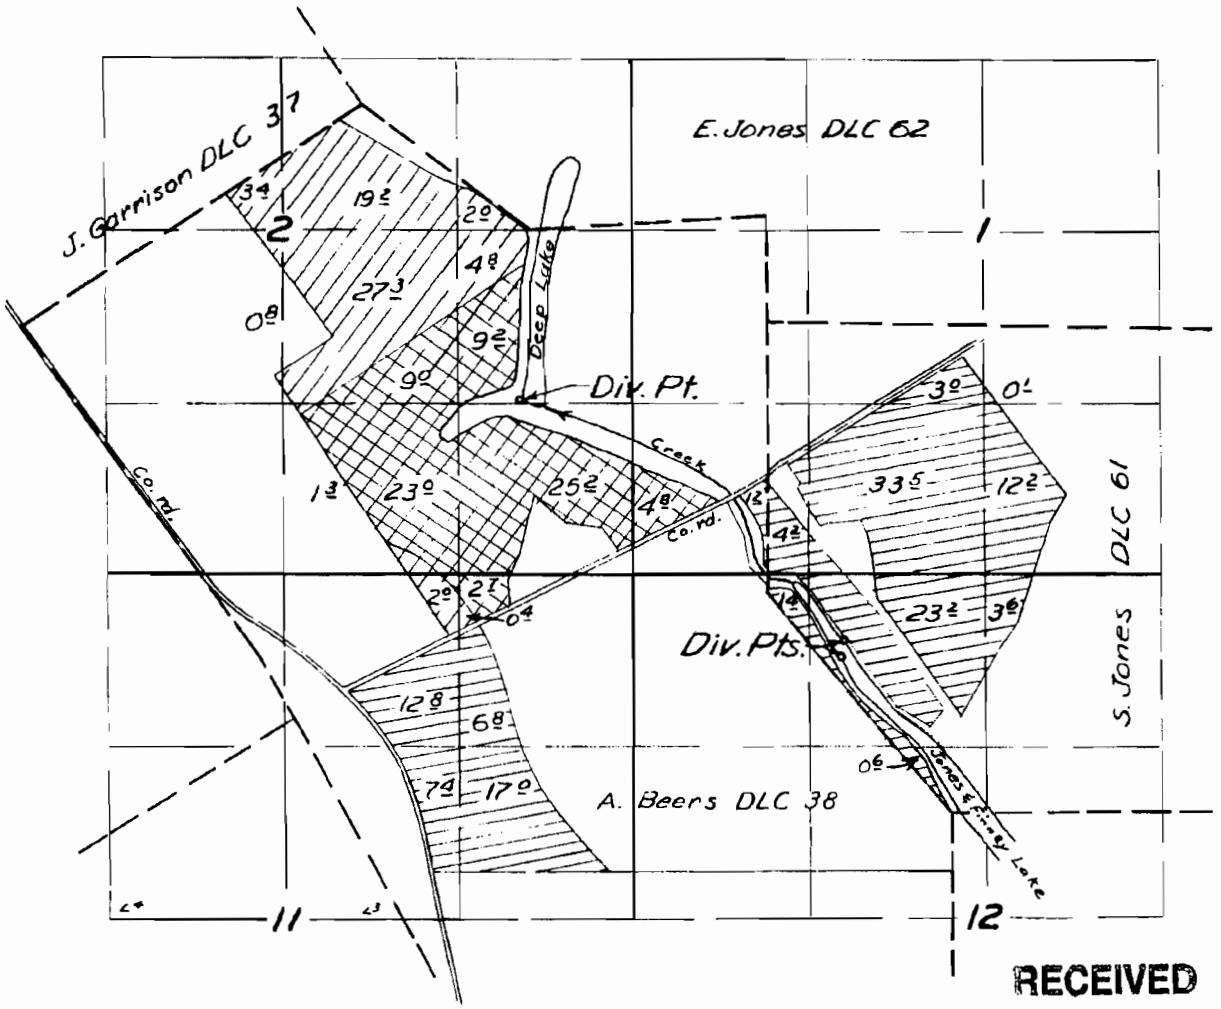

RECEIVED
OCT 09 2008
WATER RESOURCES DEPT
SALEM, OREGON

FINAL PROOF SURVEY

UNDER

Application No. 28286 Permit No. 22354

IN NAME OF

Creighton B. Jones

Surveyed 5 Sept. 1956, by Jm. Bish

From Deep Lake Prim. ▨ Supp ▩
From Jones & Finney Lake ▨

1956 K
DFN-3D-50

T 10602