


# T26S.R6W.W.M.

1 INCH = 1320 FEET

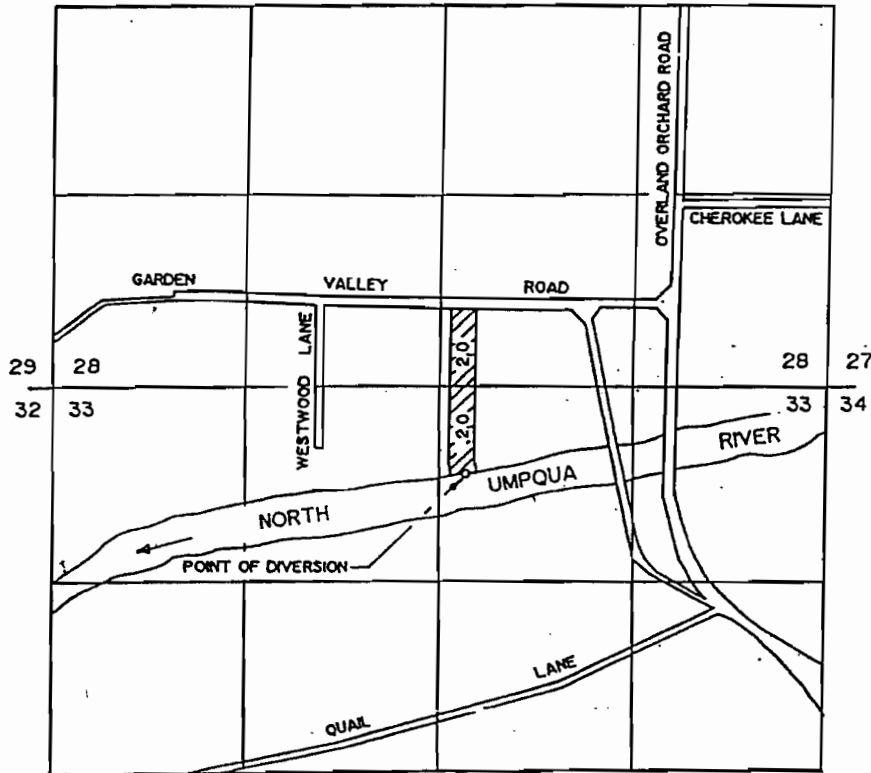

FISH SCREEN IS AT THE POINT OF DIVERSION

THE POINT OF DIVERSION IS TO BE LOCATED 600 FEET SOUTH AND 180 FEET EAST FROM THE NORTH 1/4 CORNER OF SECTION 33, BEING WITHIN THE NW 1/4 OF THE NE 1/4 OF SECTION 33, TOWNSHIP 26 SOUTH, RANGE 6 WEST, W.M., DOUGLAS COUNTY.

THE PURPOSE OF THIS MAP IS TO IDENTIFY THE LOCATION OF THE WATER RIGHT. IT IS NOT INTENDED TO PROVIDE INFORMATION RELATIVE TO THE LOCATION OF PROPERTY OWNERSHIP BOUNDARY LINES.



## FINAL PROOF SURVEY UNDER

Application No. 71807 Permit No. 51792  
IN NAME OF  
GERALD E. AND GAY L. TANNER

Surveyed JAN 8 1999 by DUANE KIRBY

RECEIVED

MAR 27 2009

WATER RESOURCES DEPT  
SALEM, OREGON