


RECEIVED

SEP 30 1999

WATER RESOURCES DIV.
SALEM, OREGON

T9S. R11W., W.M.
US Lot 2, NE1/4 - SW1/4 &
NW1/4 - SE 1/4 SECTION 29 W.M.
LINCOLN COUNTY, OREGON
Scale: 1 inch = 1320 feet

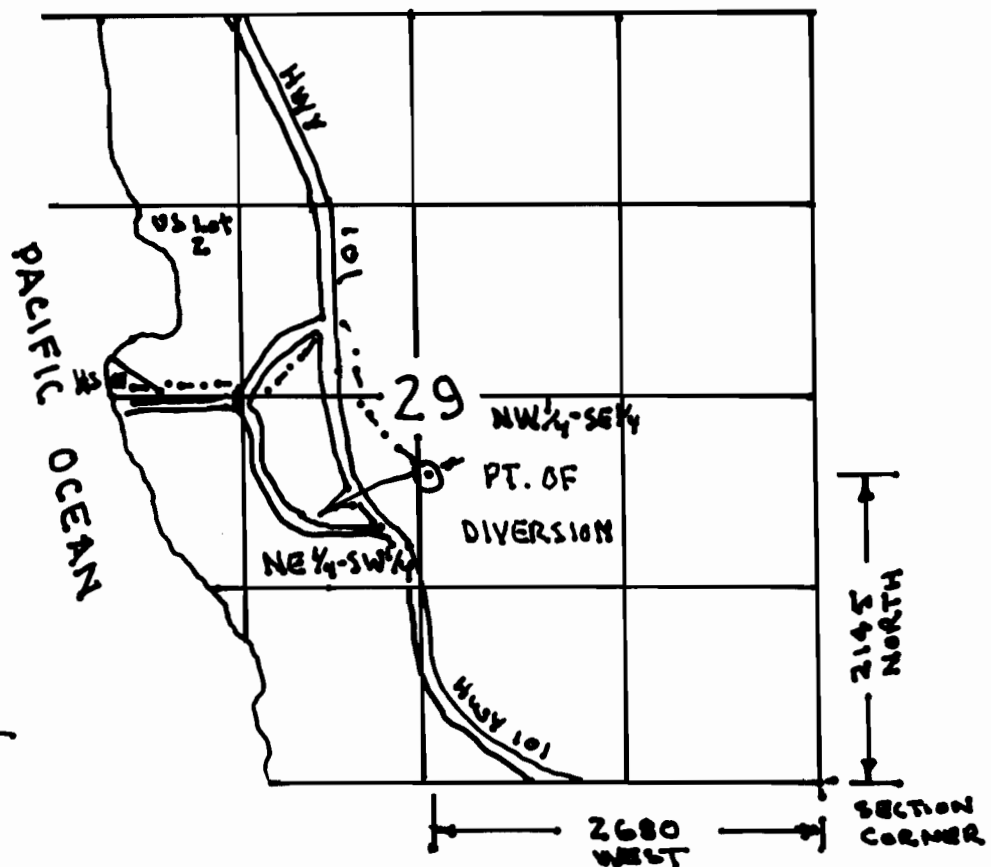

FINAL PROOF SURVEY
UNDER

APPLICATION # S-71514

PERMIT # 52685

IN THE NAME OF

Katherine Peyton

SURVEYED: September 20, 1999

BY: J. M. DENISON

THIS MAP PREPARED SOLEY FOR THE PURPOSE OF SHOWING LOCATION OF A WATER RIGHT, AND IS NOT INTENDED FOR USE FOR PROVIDE DIMENSIONS OR LOCATION OF PROPERTY OWNERSHIP LINES.