

ORIGINAL AMENDED - DO NOT REMOVE

T. 14 S.R. 4 K.L.U.M.

LINN COUNTY, OREGON

8

9

17

16

PEORIA ROAD

LOCAL POINT OF DIVERSION
IS 1880.0 FEET EAST AND
NORTH 2040.0 FEET FROM
THE S.W. COR. DLC 40.42.

RECEIVED

JUN - 3 1997

WATER RESOURCES DEPT.
SALEM, OREGON

SCALE 1:1320

S.W. COR.
DLC 40.42

17 16

16 15
21 22

20 21 LIXON

DRIVE

SE COR.
DLC 40.42

17 16

20

21

22

21 LIXON

22

SW COR.
DLC 40.42

20

21

22

FINAL PROOF SURVEY

UNDER

APPLICATION S-73300 PERMIT NO. 51919

IN NAME OF

KURT KAYHER

SURVEYED APRIL 17, 1997 BY: CHARLES W. GUILE

MCKEENIE RIVER POINT OF
DIVERSION IS IN SEC. 5, T. 17
S.R. 3 K.L.U.M. BEING 4440.0
FEET SOUTH AND 525.0 FEET
EAST FROM THE SE. COR.
OF D.L.C. 40.79.


THIS MAP IS FOR WATER RIGHT
PURPOSE ONLY AND IS NOT
INTENDED TO PROVIDE
DIMENSIONS FOR LOCATING
PROPERTY BOUNDARIES.

Amended by WRD Staff,

12-10-08

7wg


PRIORITY DATE
MARCH 30, 1993

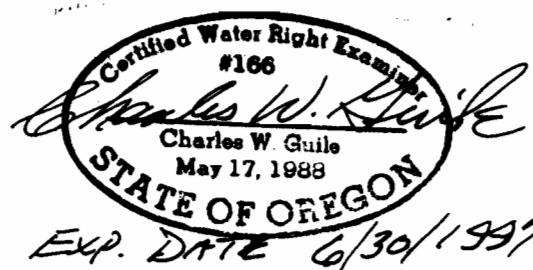

CHARLES W. GUILE
& ASSOCIATES, CO.
Land Surveying
52 Centennial Loop
Eugene, OR 97401

92-41 E

T. 14 S. R. 4 K.L.W.M.
LINN COUNTY, OREGON

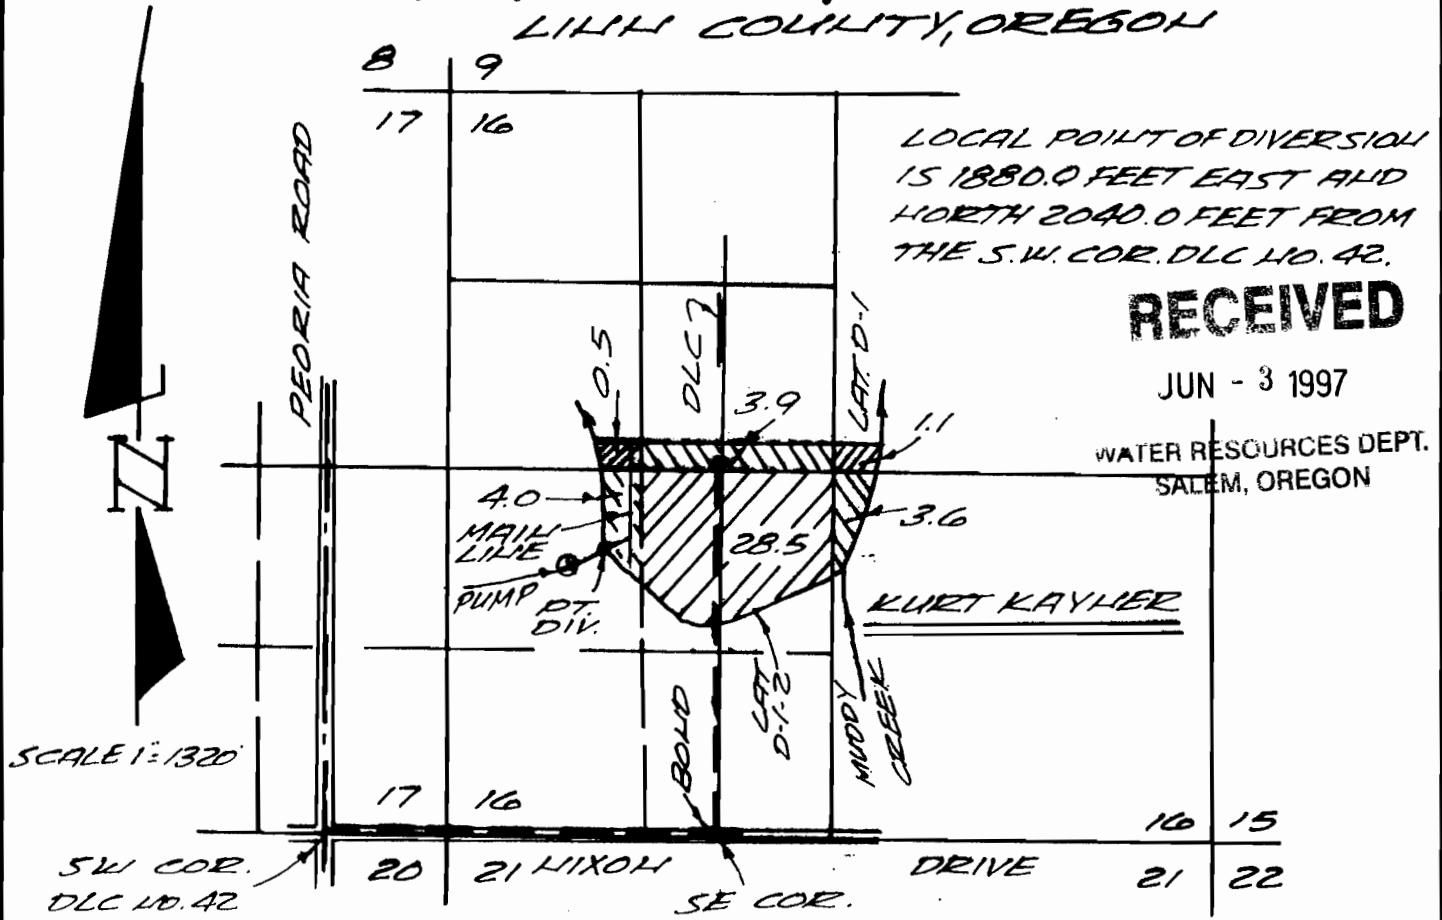

**FILIAL PROOF SURVEY
UNDER**

APPLICATION S-73300 PERMIT NO. 51919

IN NAME OF
KURT KAYLER

SURVEYED APRIL 17, 1997 BY: CHARLES W. GUILE

MCKELZIE RIVER POINT OF
DIVERSION IS IN SEC. 5, T.17
S.R. 3 W.L.W.M. BEING 4440.0
FEET SOUTH AND 525.0 FEET
EAST FROM THE S.E. COR.
OF D.L.C. NO. 79.

PRIORITY DATE
MARCH 30, 1993



THIS MAP IS FOR WATER RIGHT
PURPOSE ONLY AND IS NOT
INTENDED TO PROVIDE
DIMENSIONS FOR LOCATING
PROPERTY BOUNDARIES.

CHARLES W. GUILE
& ASSOCIATES, CO.
Land Surveying
62 Centennial Loop
Eugene, OR 97401

92-41 E