


Township 9 S., Range 31 E., W.M.

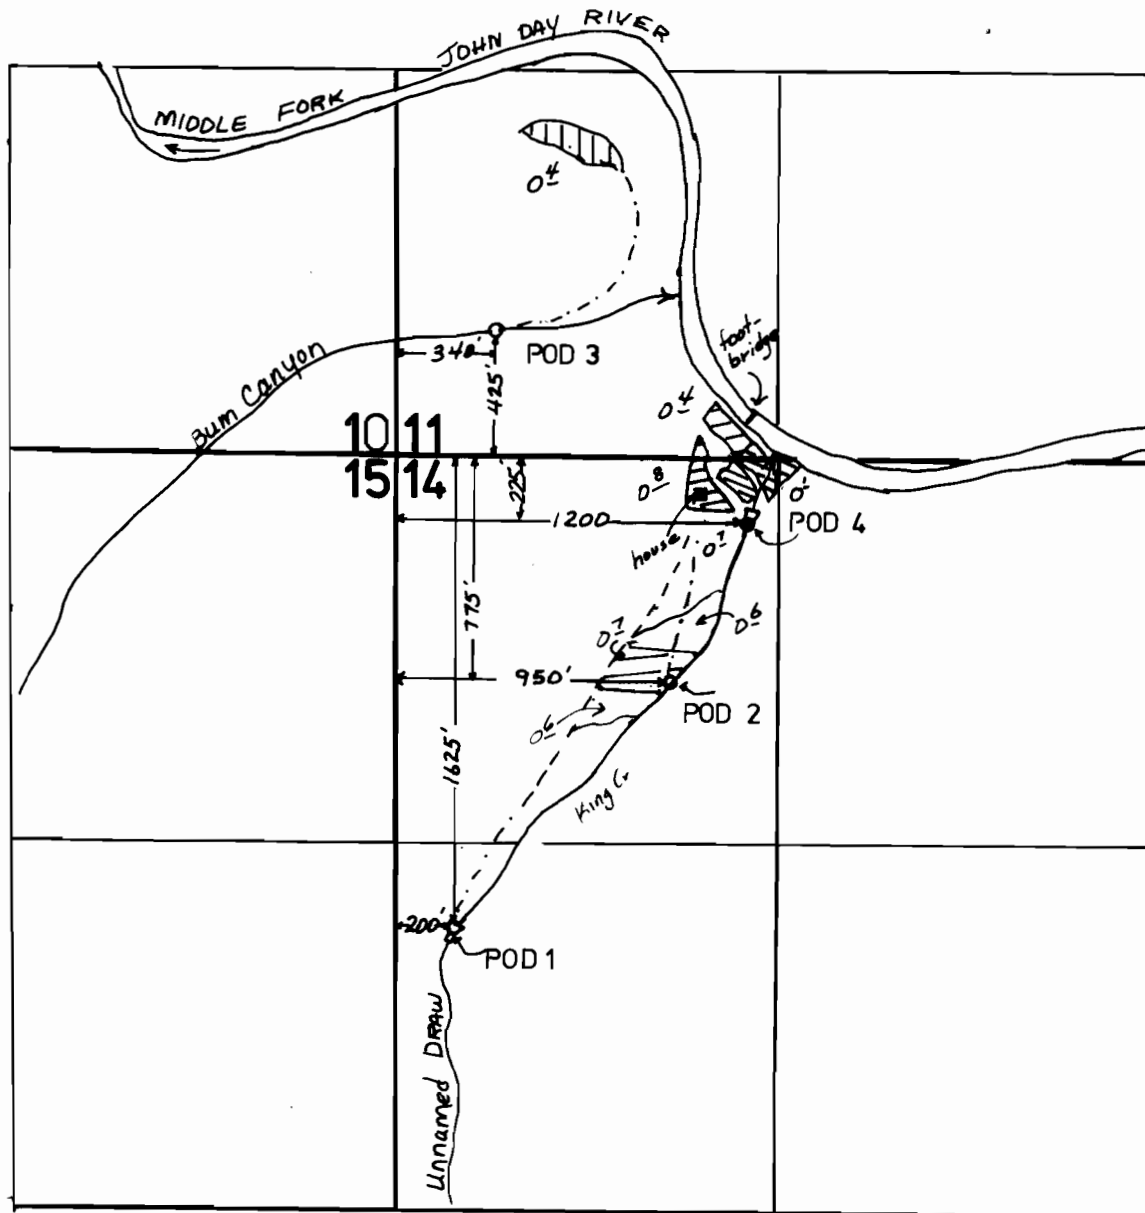

N
1" = 660'



POD 1



POD 4



POD 3

FINAL PROOF SURVEY UNDER

Application No. ⁶⁴⁵⁴²~~56542~~ Permit No. 47236

IN NAME OF

William C. Dixon and Pamela Bunge

Surveyed Sept. 15 19.99, by J. Miller