T. 9S. R.2W. W.M.

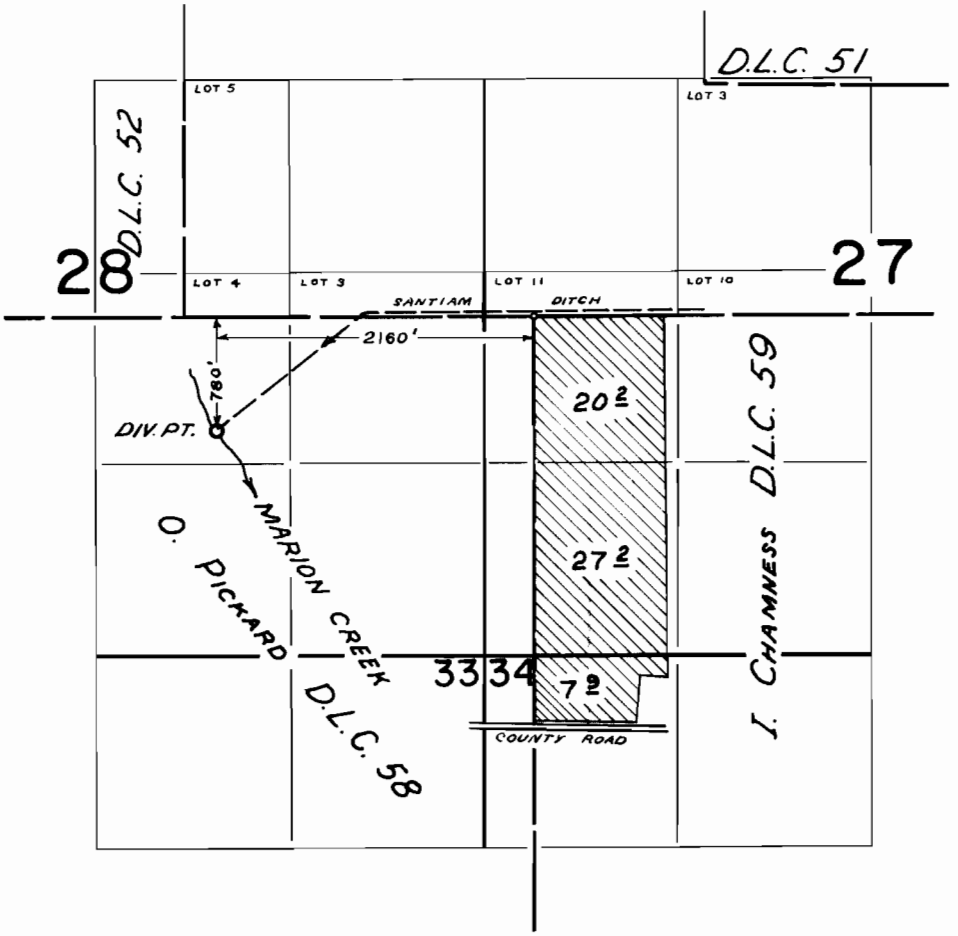

FINAL PROOF SURVEY
UNDER

Application No. 37131 Permit No. 27664
IN NAME OF

Gottfried Schelske

Surveyed JUN 16 1965, by C. GARDNER

1965-M RAB