


SECTION 27 T.1N. R.10W.W.M.
TILLAMOOK COUNTY

1"=400'

IN 10 27
& INDEX

This map was prepared for
assessment purpose only.

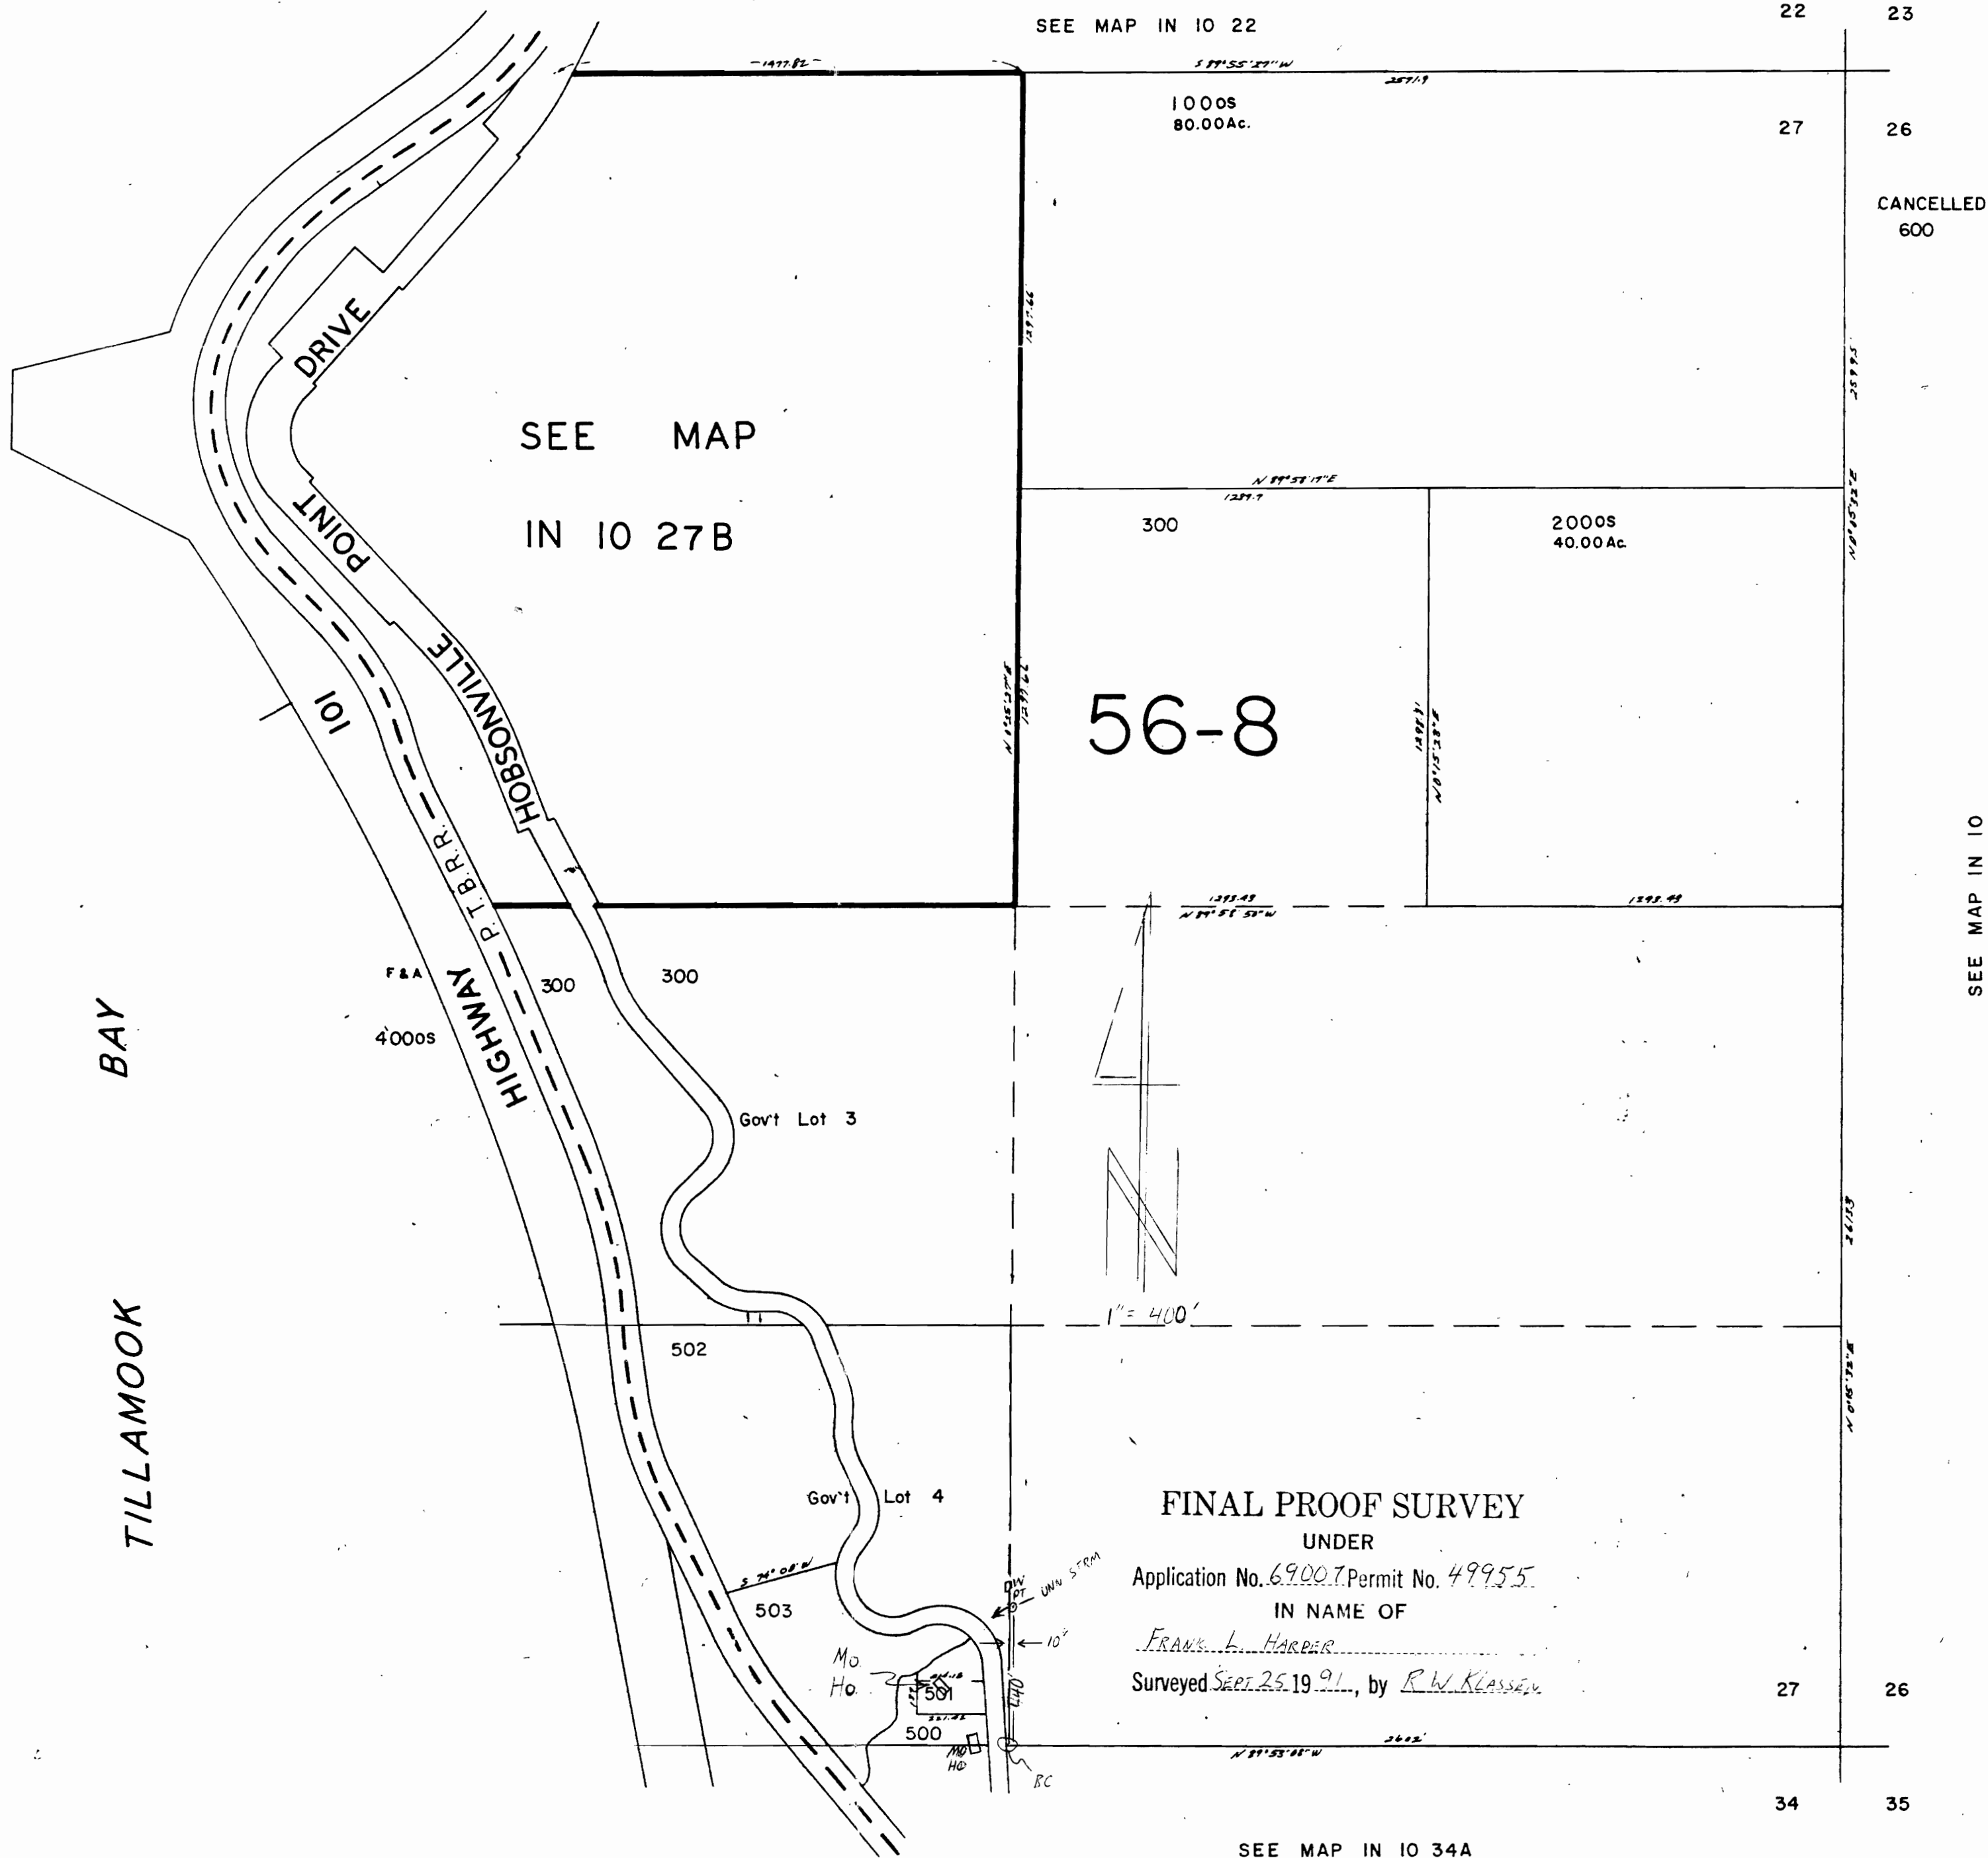

IN 10 27
& INDEX