

SECTIONS 25, 26, 27, 34, & 35, TWP.4 S. RANGE 14 E. W.M.

WASCO COUNTY, OREGON


RECEIVED

JUL 13 2000

WATER RESOURCES DEPT.
SALEM, OREGON

**WATER RIGHT
FINAL PROOF SURVEY**

SCALE: 1"= 1320'

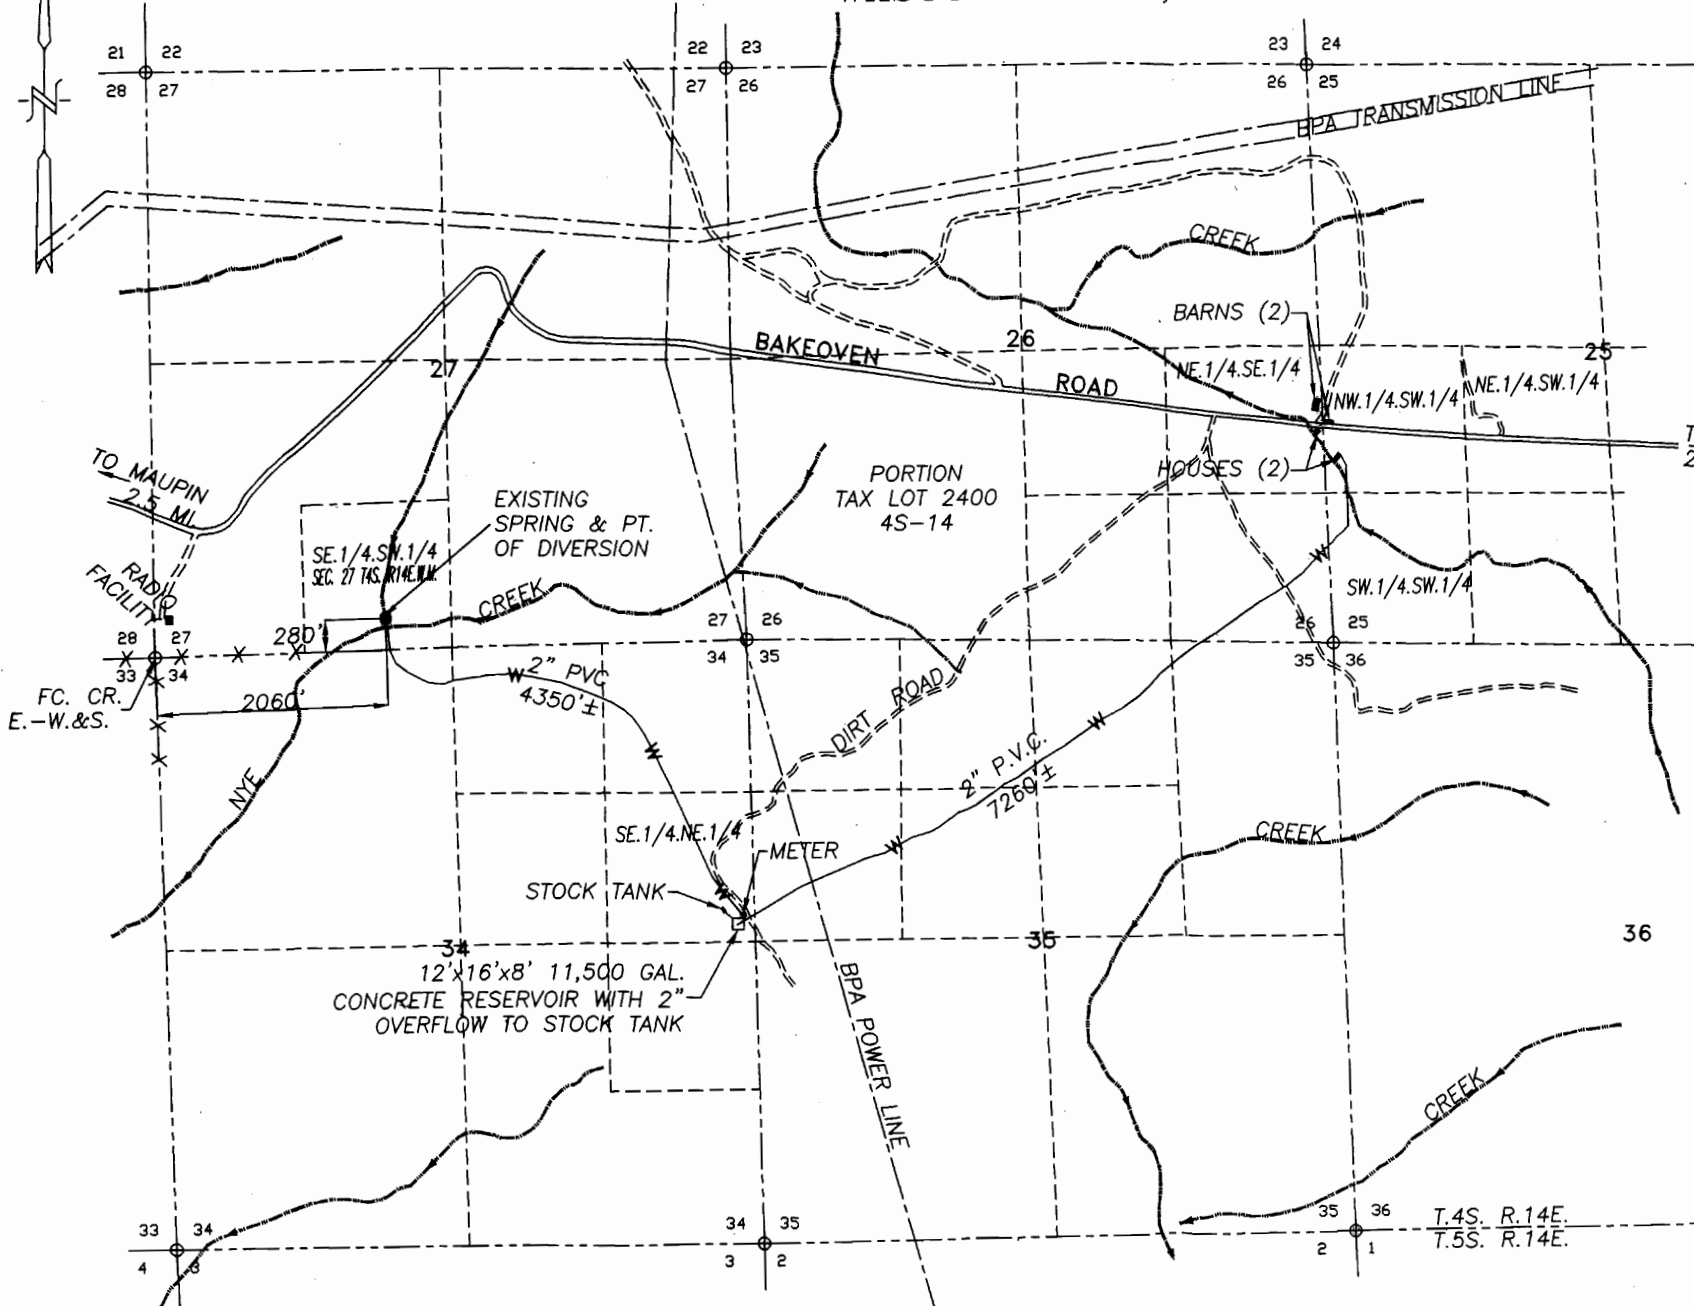


APPLICATION No. S-73280

PERMIT No. 52730

IN THE NAME OF:
CONNELLY LAND & LIVESTOCK, INC.

DATE: JULY 7, 2000

BY: TENNESON ENGINEERING CORP.
409 LINCOLN STREET,
THE DALLES, OREGON. 97058
PH. (541) 296-9177
FAX (541) 296-6657

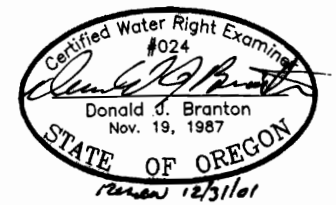

NOTE:
"THIS MAP IDENTIFIES THE LOCATION OF THE WATER RIGHT ONLY AND IS NOT INTENDED TO PROVIDE DIMENSIONS OR LOCATE PROPERTY OWNERSHIP LINES."