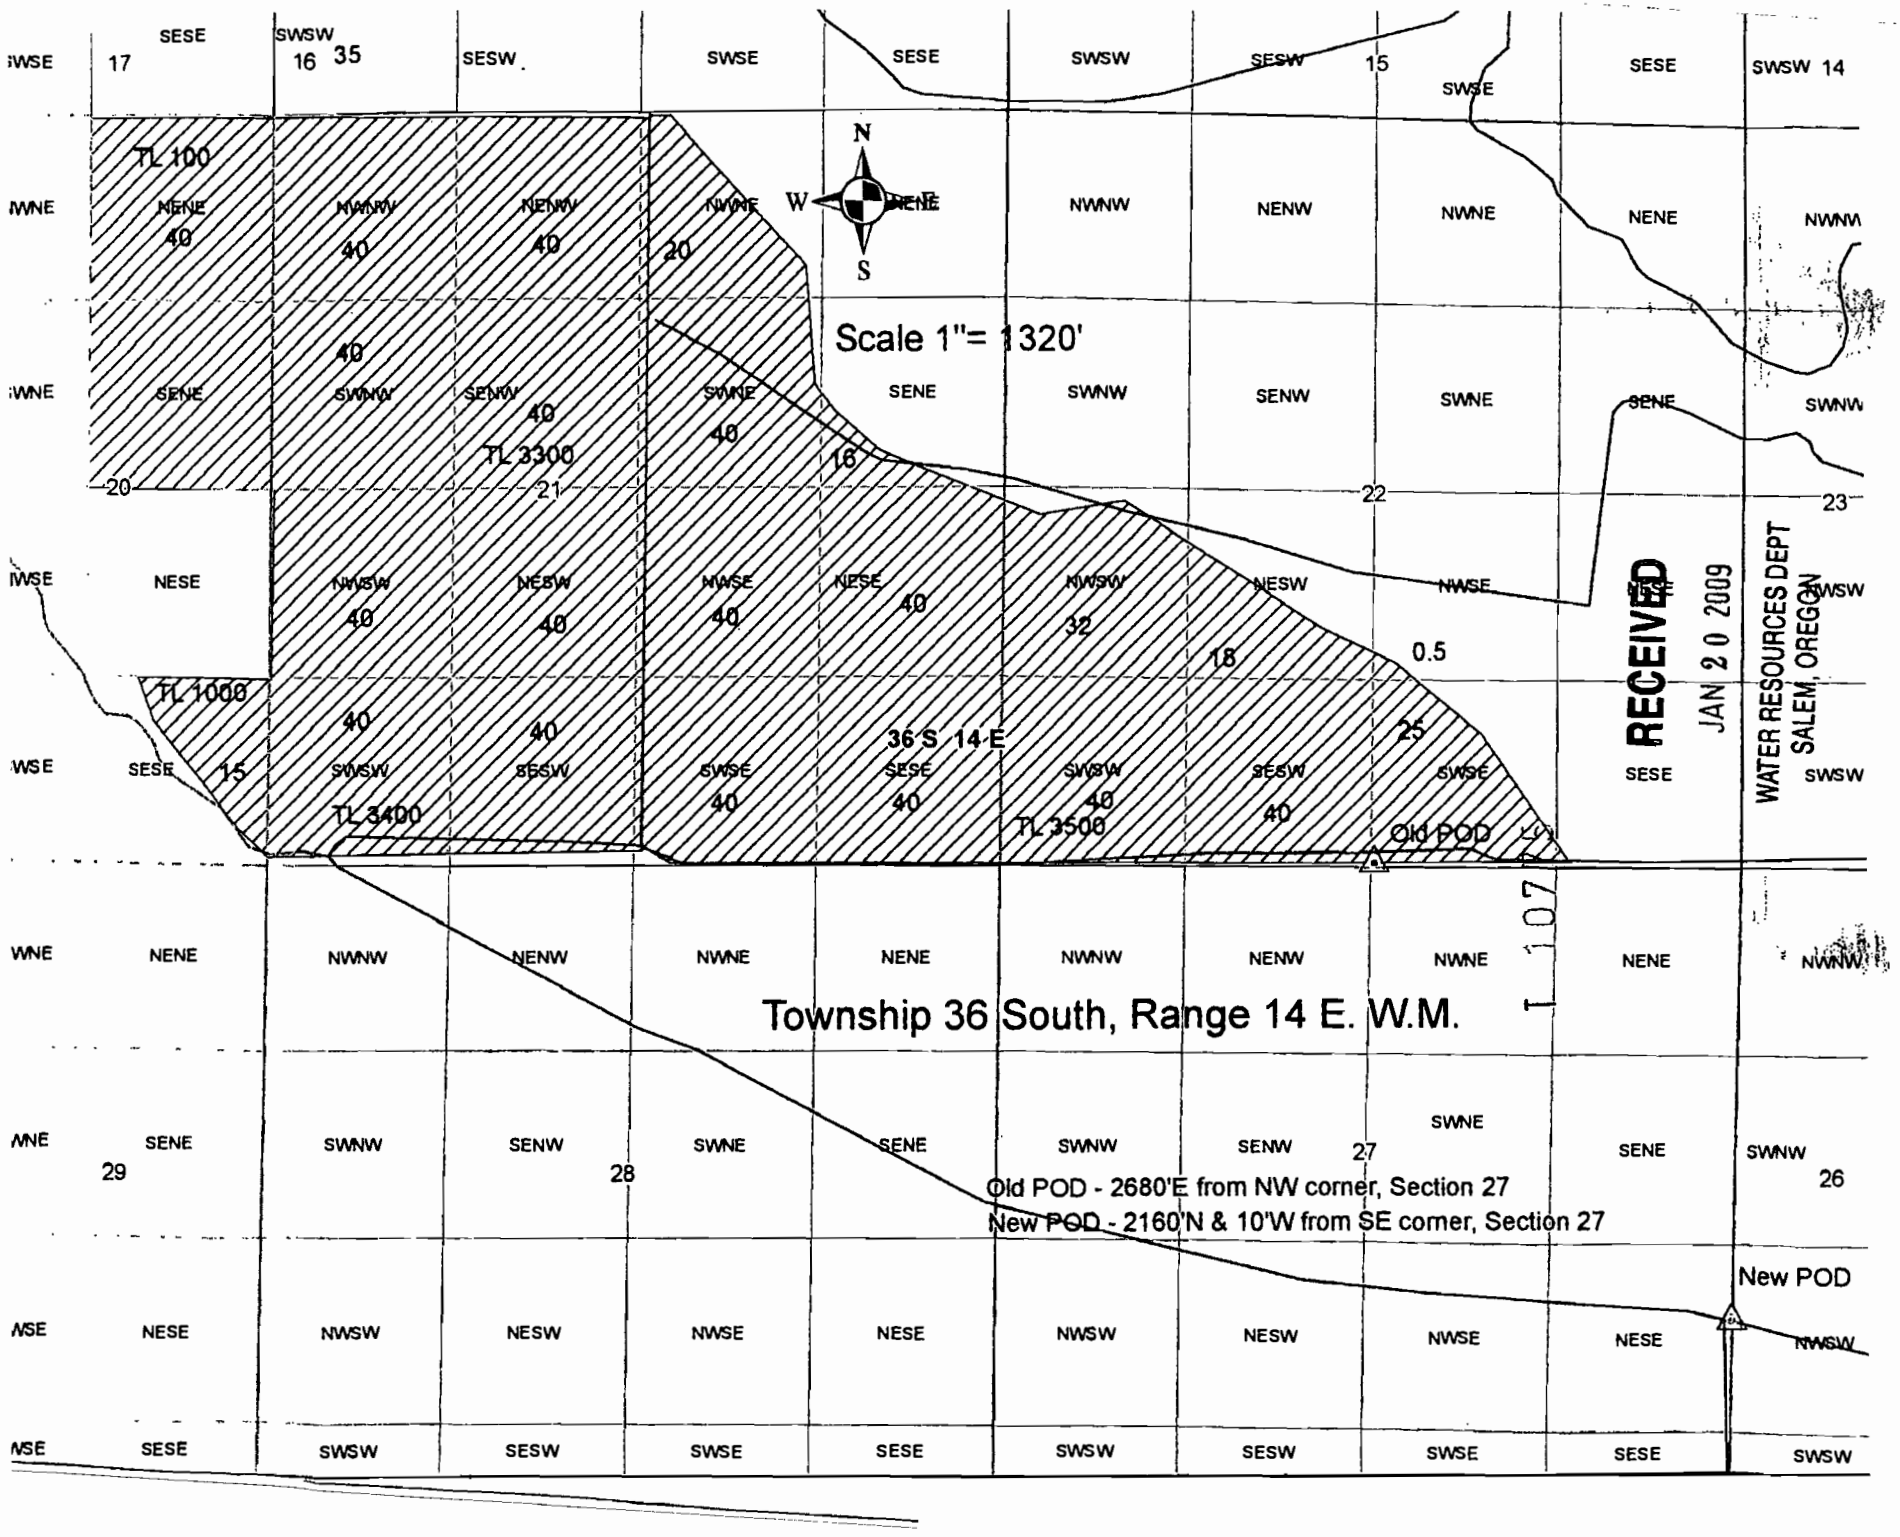
Scale 1"= 1320'
N
S
W
E
TL 100
TL 1000
TL 3300
TL 3400
TL 3500
36 S 14 E
Old POD
New POD
Township 36 South, Range 14 E. W.M.
Old POD - 2680'E from NW corner, Section 27
New POD - 2160'N & 10'W from SE corner, Section 27
RECEIVED
JAN 20 2009
WATER RESOURCES DEPT
SALEM, OREGON