


Tax Lot No. TL1000 29 14 20

Section 20 Township 29 S Range 14 W W.M.

Coos County

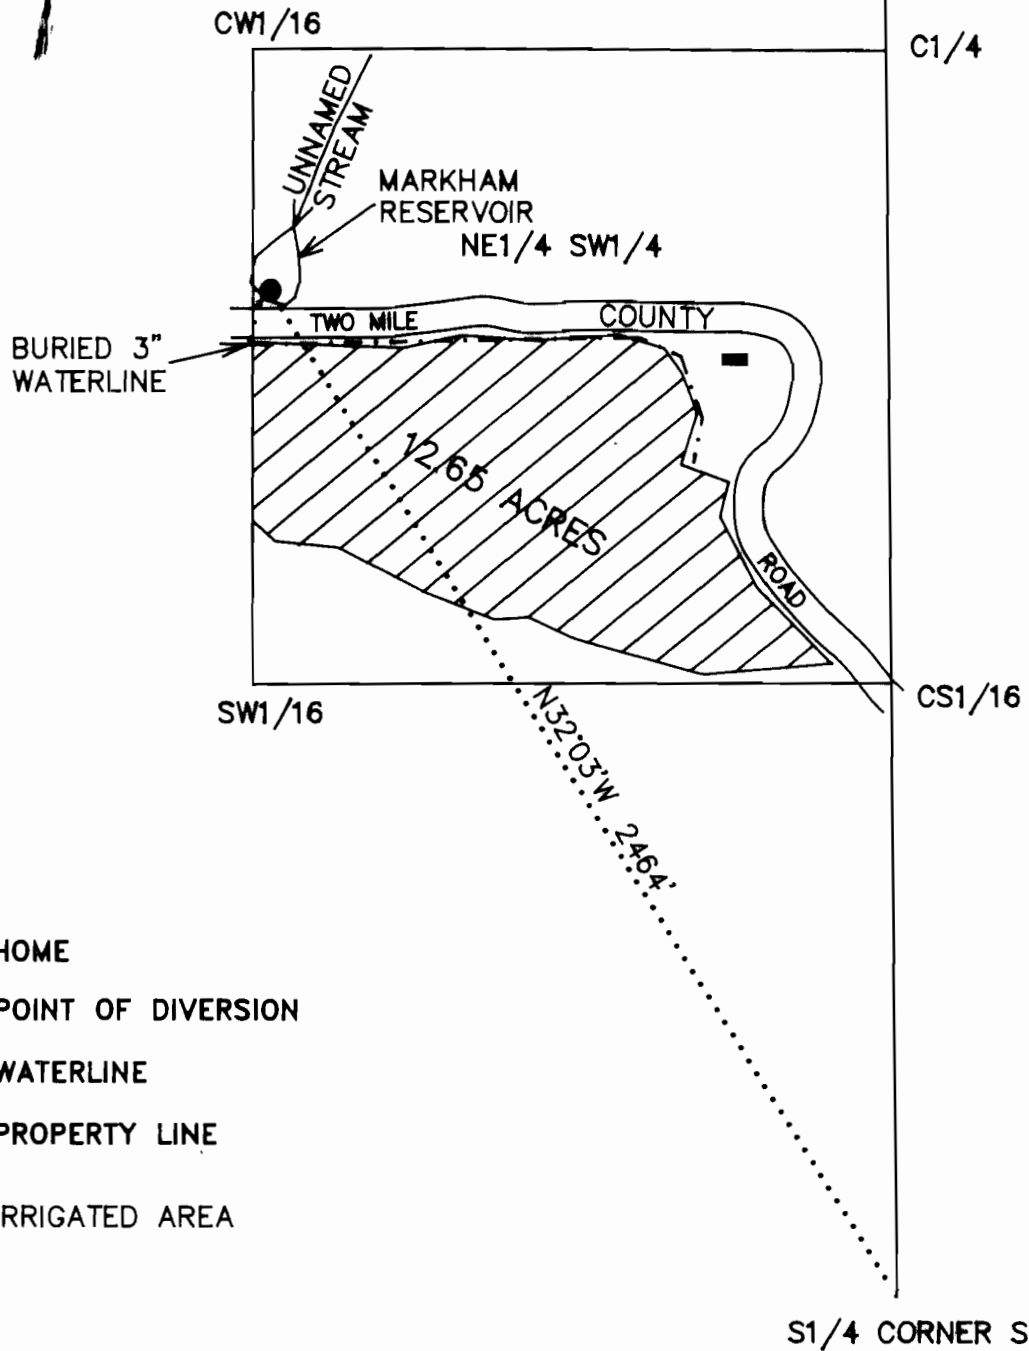

**LEGEND**

- HOME
- POINT OF DIVERSION
- - - - WATERLINE
- . . . . PROPERTY LINE
- ▨ IRRIGATED AREA


**EXAMINERS DISCLAIMER STATEMENT**

The preparation of this map was for the purpose of identifying the location of the Water Right only and has no intent to provide dimensions or location of property ownership lines.

**RECEIVED**

JUN 27 2001

WATER RESOURCES DEPT.  
SALEM, OREGON

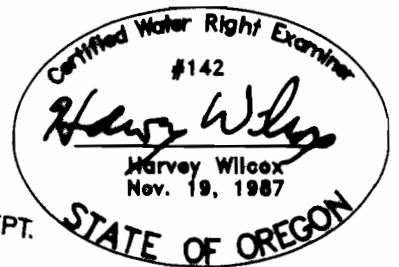

RENEWAL 6/30/02

**FINAL PROOF SURVEY**

IN THE NAME OF

Donald L. and Linda Markham

Surveyed on 2/113/01 by H.A. Wilcox

Application No. S-72644

Permit No. 51738