



Tax Lot No. TL1000 29 14 20

Section 20 Township 29 S Range 14 W W.M.

Coos County

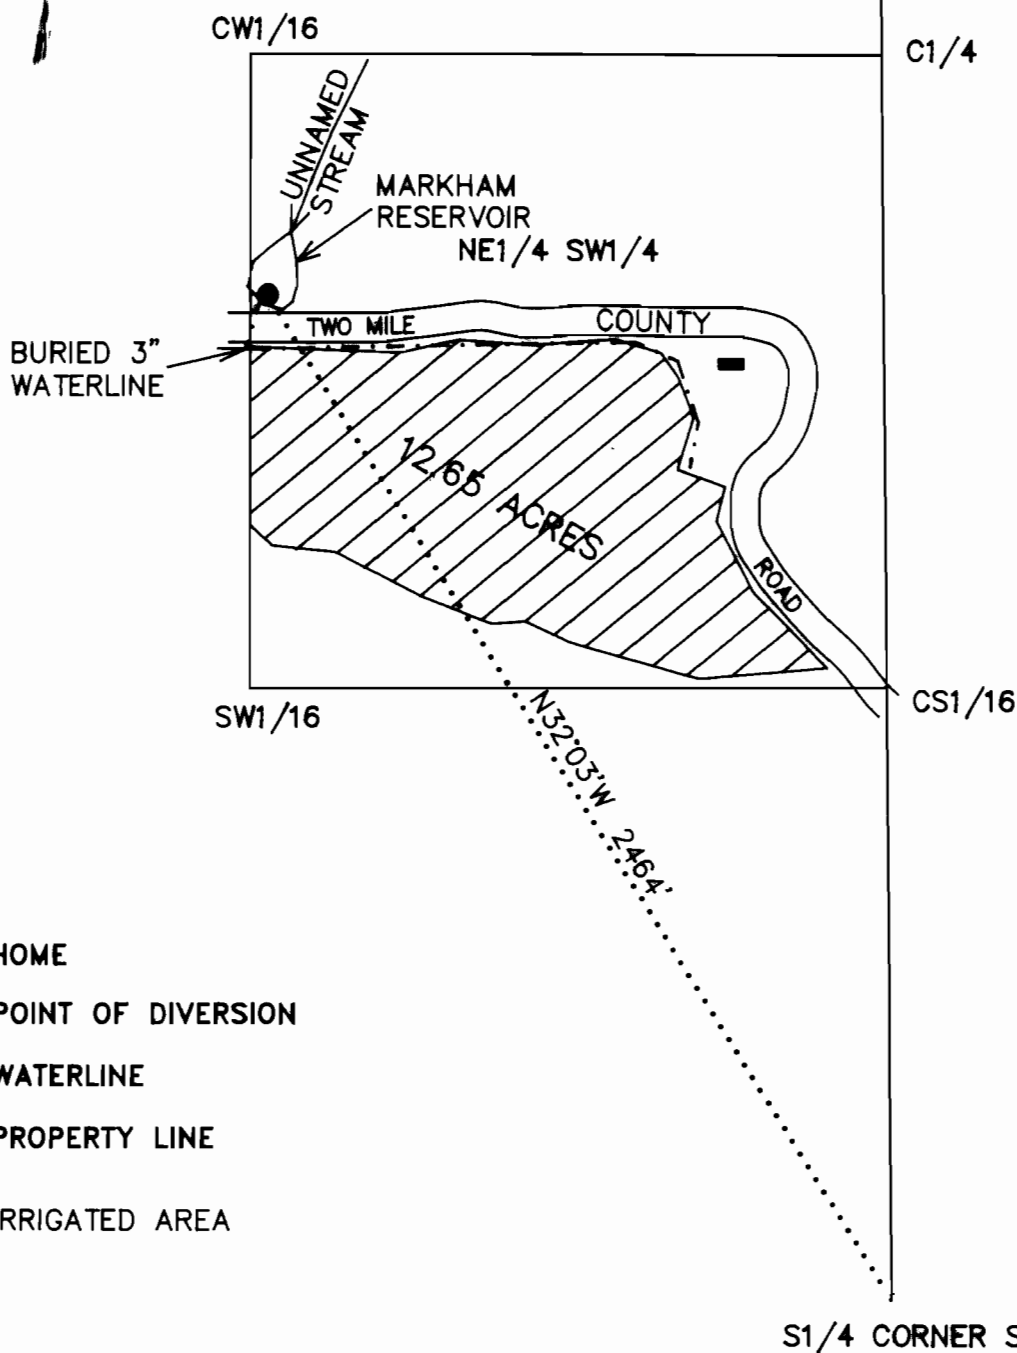

LEGEND

- HOME
- POINT OF DIVERSION
- - - - WATERLINE
- · · - PROPERTY LINE
-  IRRIGATED AREA

EXAMINERS DISCLAIMER STATEMENT

The preparation of this map was for the purpose of identifying the location of the Water Right only and has no intent to provide dimensions or location of property ownership lines.


FINAL PROOF SURVEY
IN THE NAME OF
Donald L. and Linda Markham

Surveyed on 2/113/01 by H.A. Wilcox

RECEIVED

JUN 27 2001

WATER RESOURCES DEPT.
SALEM, OREGON

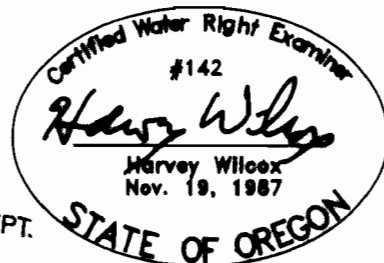

RENEWAL 6/30/02

Application No. S-72644

Permit No. 51738