


T. 34 S., R. 1 W., W. M.

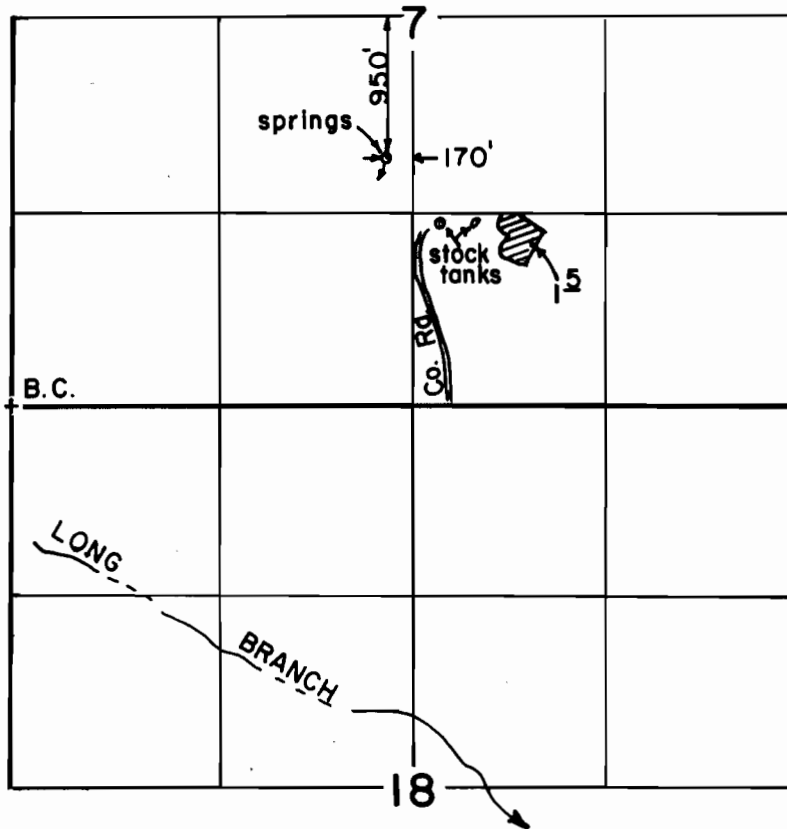

Scale: 1" = 1320'

**FINAL PROOF SURVEY
UNDER**

Application No. 50745. Permit No. 38218.....
IN NAME OF

.....JUDITH C. STEADMAN.....

Surveyed JULY.25. 1991.., by R.S.JAMES....