


Application No. 43806-R-44043
 Permit No. 33236-B-5253

Proposed
 Water Use Project
 Portions of Sec. 7, 8, 17 & 18
 T.35S., R.14E., W.M.
 Klamath County, Oregon
 Applicant O'Connor Livestock Co.
 Survey by Thompson & Warnke
 Scale 4" = 1 Mile Date July 1, 1967
 Total Acres in project - 271 A.

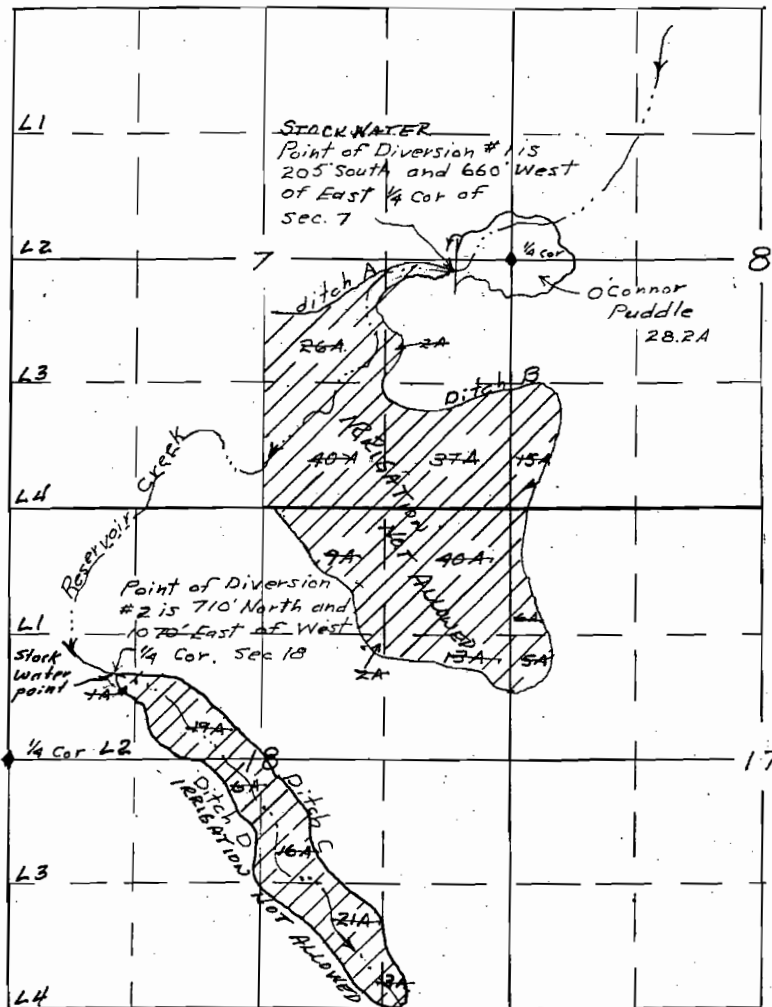

| | Length |
|---------|--------|
| Ditch A | 2100' |
| Ditch B | 11100' |
| Ditch C | 5100' |
| Ditch D | 4800' |



RECEIVED SEP 8 1967 STATE ENGINEER SALEM OREGON
 RECEIVED JUL 12 1967 STATE ENGINEER SALEM OREGON