


CLAIM OF BENEFICIAL USE
 FOR: WILLIS B. HAYES AND
 WENDY SUE LAMB
 BY: DUANE W. KIRBY
 T24S, R4W W.M.
 DOUGLAS COUNTY
 TAX LOT 500
 APPLICATION NO. S-80414
 PERMIT NO. 53702
 SCALE: 1" = 1320'

RECEIVED

WATER RESOURCES DEPT
 SALEM OREGON

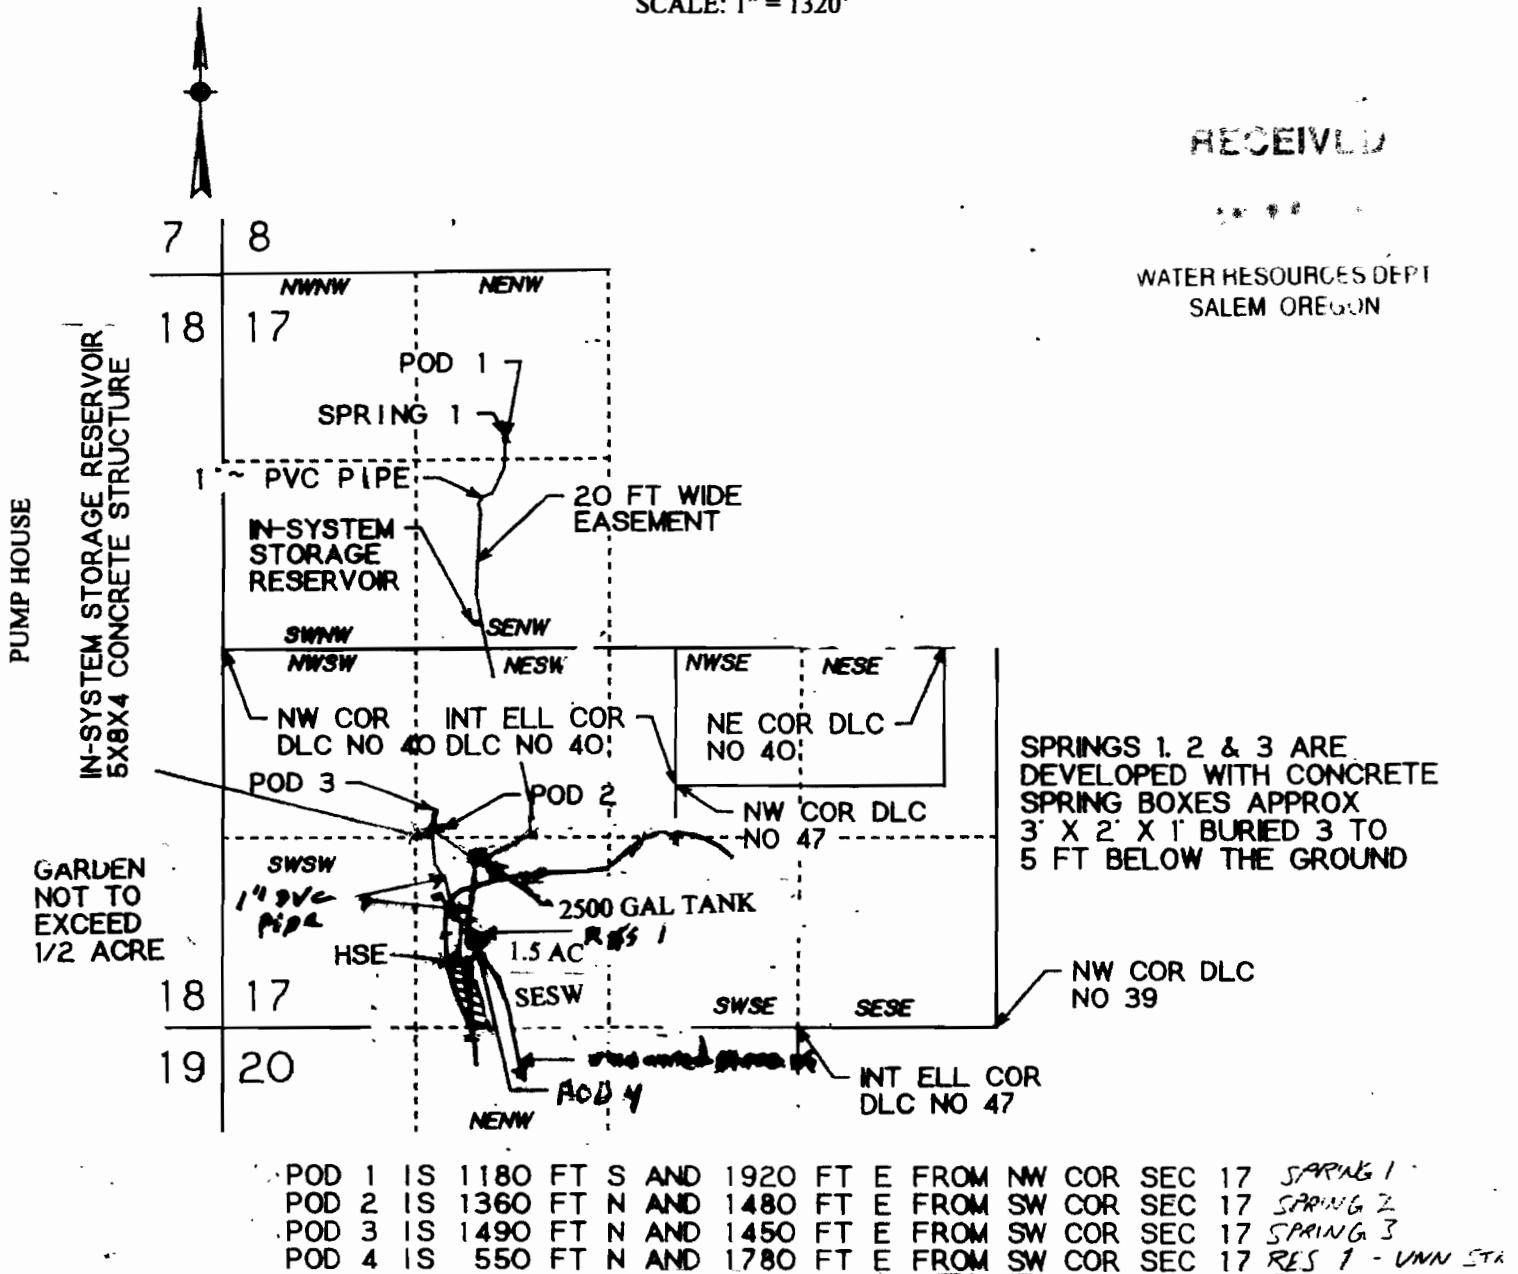

THE PURPOSE OF THIS MAP IS TO
 IDENTIFY THE LOCATION OF THE
 WATER RIGHT. IT IS NOT INTENDED
 TO PROVIDE INFORMATION RELATIVE
 TO THE LOCATION OF PROPERTY
 OWNERSHIP BOUNDARY LINES.

