


T.2N,R.12E,WM

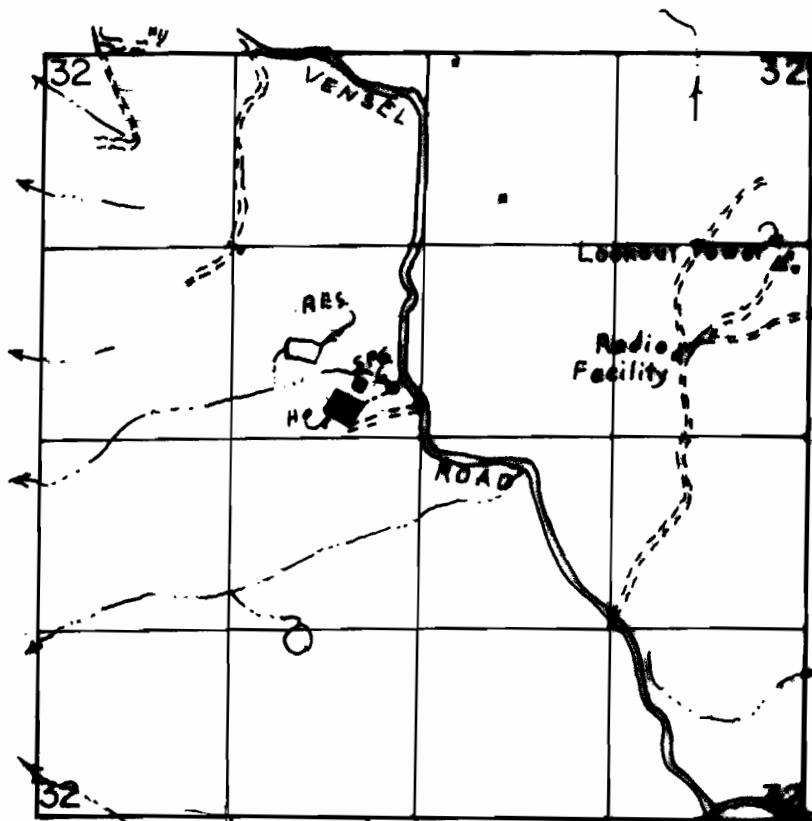

SPG. LOC: 350' N & 2425' E FROM W 1/4 COR. OF SEC 32.  
RES. LOC: IN THE SE 1/4, NW 1/4 OF SEC 32.

SCALE: 1" = 1320'

### FINAL PROOF SURVEY UNDER

Application No. <sup>67946</sup> R-67946 <sup>49539</sup> Permit No. R-9999....  
IN NAME OF

.....JILLIAN C. BARKER.....

Surveyed JULY 25, 1995, by R.M. SUTTERFIELD