


T. 8 S., R. 30 E., W.M.

RECEIVED

AUG - 4 1997

WATER RESOURCES DEPT.
SALEM, OREGON

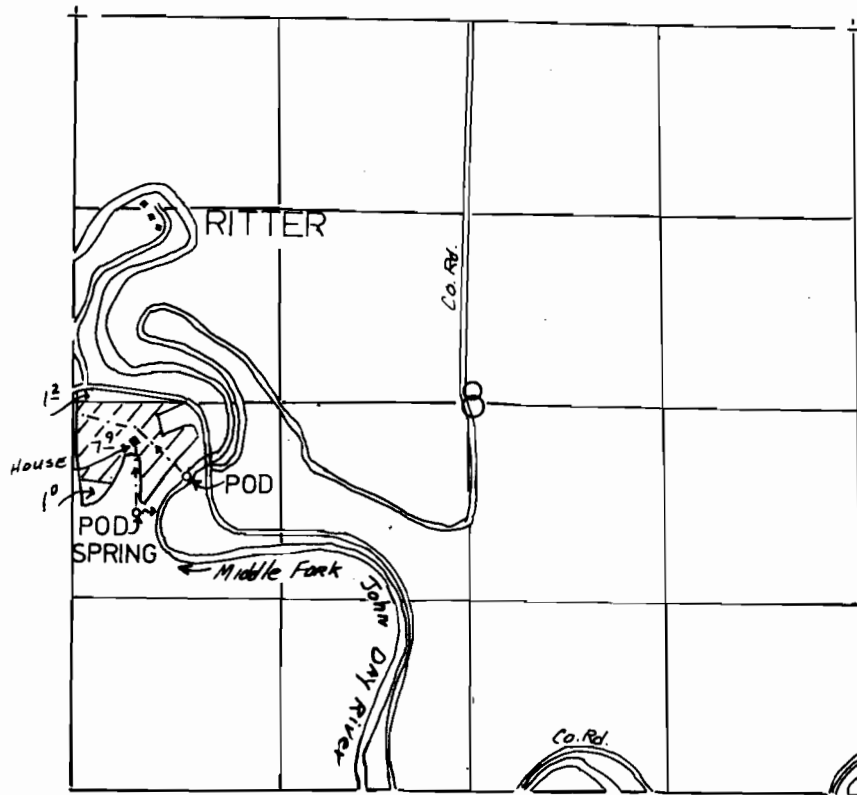

POD SPRING - 750' S. & 450' E. FROM W 1/4 COR., SEC. 8.
POD M.F.J.D. RIVER 510' S. & 780' E. FROM W 1/4 COR. SEC. 8

FINAL PROOF SURVEY

UNDER

Application No. 54014 Permit No. 40268
IN NAME OF

DOUGLAS DICKERSON

Surveyed AUGUST 30, 1991, by J. MILLER