

LEGEND



= AREA UNDER IRRIGATION



= 1/4 CORNER

— = 1/16 TH LINE

○ = WELL


== = BURIED DISTRIBUTION LINE

WELL IS LOCATED 1,030 FEET SOUTH
AND 260 FEET EAST OF WEST
1/4 CORNER OF SECTION 25,
T5N, R32E, W.M.


AREA BENEFICIALLY IRRIGATED
NW 1/4, SW 1/4 S 25: 26.96 A.
NE 1/4, SW 1/4 S 25: 0.26 A.
SW 1/4, SW 1/4 S 25: 3.23 A

TOTAL: 30.45 ACRES

THIS MAP IS PREPARED FOR THE
EXPRESS PURPOSE TO SHOW
WATER APPROPRIATION AND
USE. IT IS NOT INTENDED
TO SHOW OR LOCATE
PROPERTY OWNERSHIP LINES.

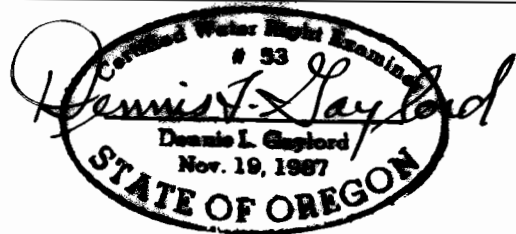

DENNIS L. GAYLORD, CWRE
4107 S.W. LAKE DRIVE
PENDLETON, OR 97801
503-276-6260

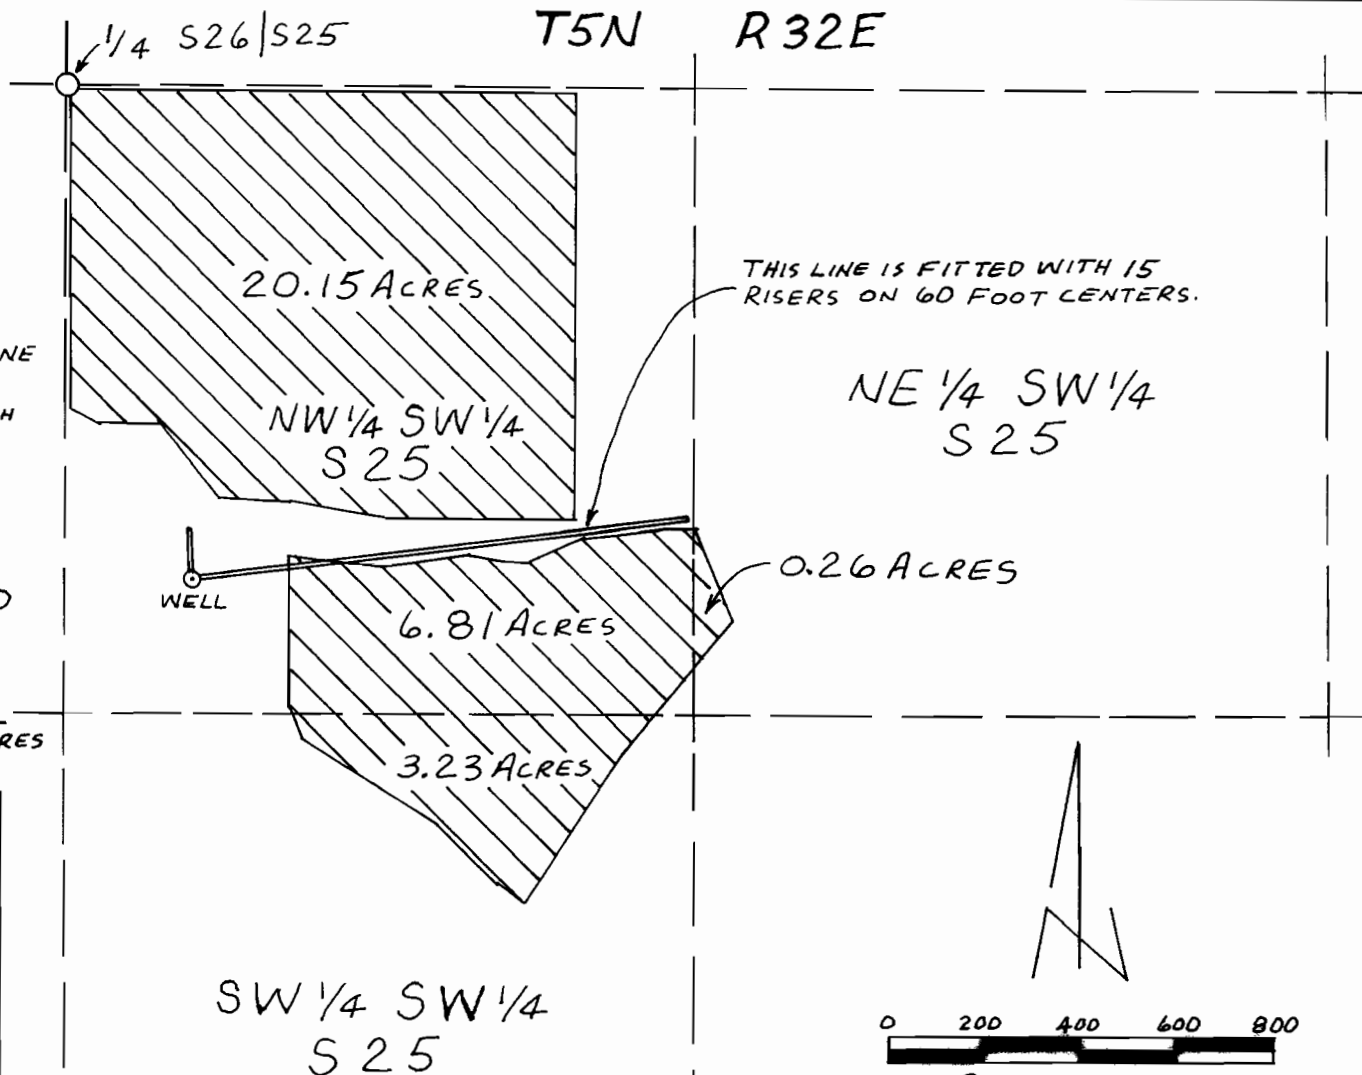

RECEIVED

FINAL PROOF SURVEY
AND
CLAIM OF BENEFICIAL USE
McRAE RANCH
NW 1/4, SW 1/4; NE 1/4, SW 1/4 & SW 1/4, SW 1/4
SECTION 25, T5N, R32E
W.M. UMATILLA COUNTY, OR.
APPLICATION G-11695
PERMIT G-10886