


# T. 34 S., R. 1 W., W. M.

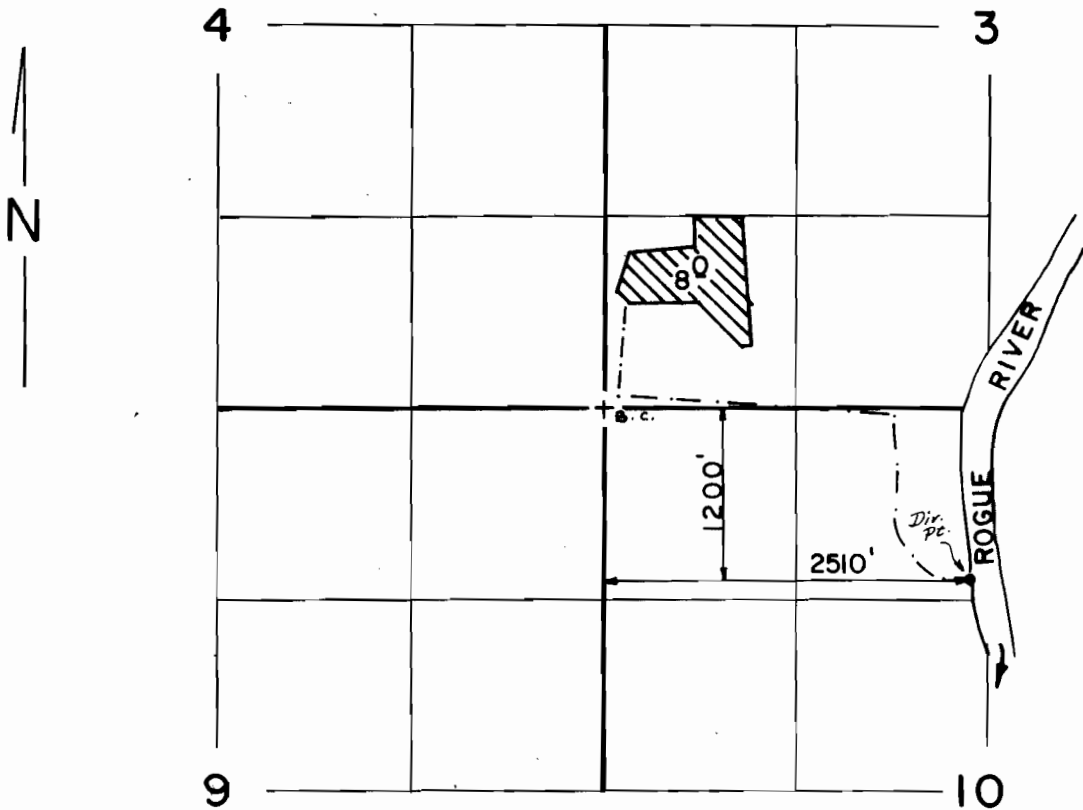

Scale: 1" = 1320'

## FINAL PROOF SURVEY UNDER

Application No. 69126.. Permit No. 50157.....  
IN NAME OF

.....Don & Darlene Paul.....

Surveyed MAR..20. 1990., by B...S...JAMES.....