


RECEIVED
 WATER RESOURCES DEPT
 SALEM, OR
 2000

T.4S. R.2W. W.M.
 MARION COUNTY

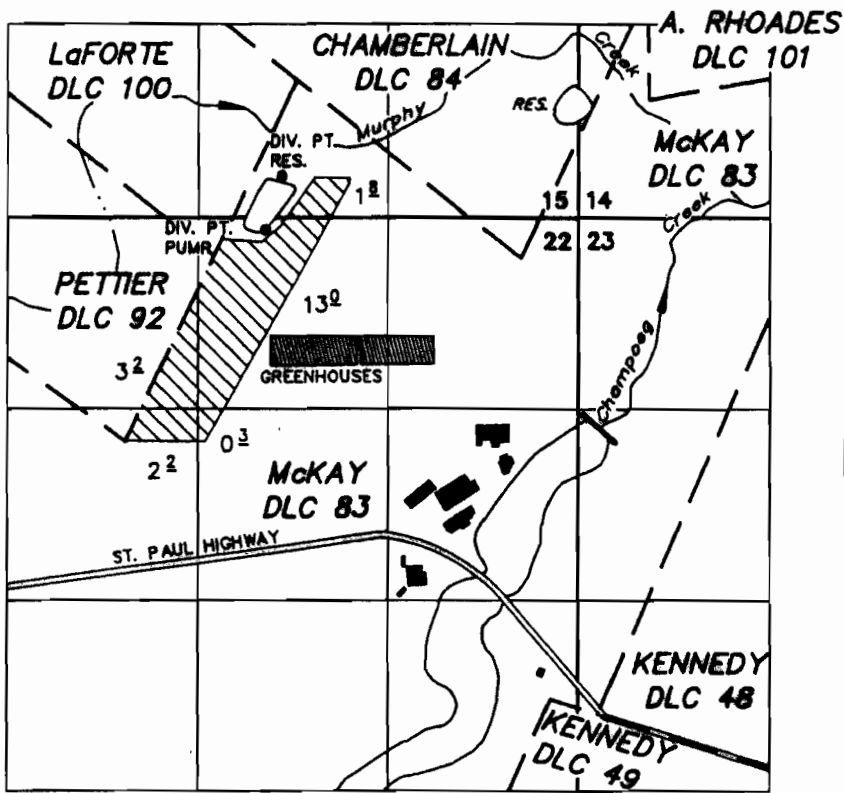

TAX LOT:
042W22 00201

RES. DIV. PT.: 1080' E & 1825' N FROM THE SE COR PETTIER DLC 92
 PUMP DIV. PT.: 965' E & 1460' N FROM THE SE COR PETTIER DLC 92

FINAL PROOF SURVEY
 UNDER

| | | | |
|-----------------|---------|--------------------|-----------------------|
| | G-1761 | G-1608 | 32579 |
| | G-12714 | G-11673 | |
| | R-80563 | R-12123 | |
| Application No. | S-80564 | Permit No. S-52890 | Certificate No. _____ |

A & R SPADA FARMS

SEPTEMBER 14, 1999
 SCALE: 1" = 1320'

NOTE: This map is for the purpose of identifying the location of water rights and has no intent to dimension or locate property ownership lines.

