


RECEIVED
 WATER RESOURCES DEPT
 SALEM, OR
 2000

T.4S. R.2W. W.M.
 MARION COUNTY

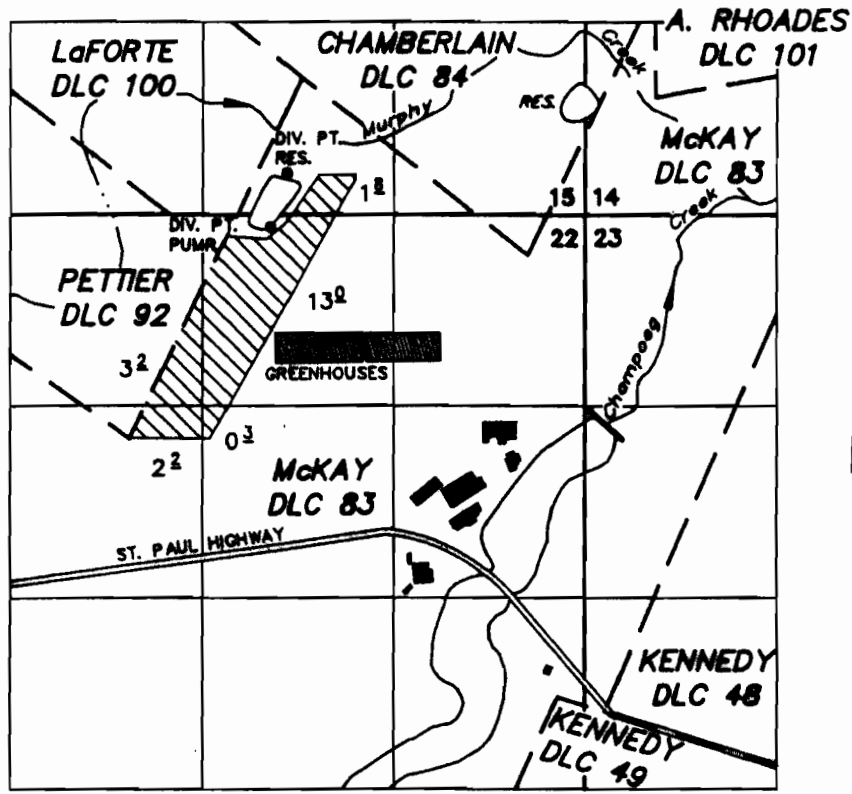

TAX LOT:
 042W22 00201

RES. DIV. PT.: 1080' E & 1825' N FROM THE SE COR PETTIER DLC 92
 PUMP DIV. PT.: 965' E & 1460' N FROM THE SE COR PETTIER DLC 92

FINAL PROOF SURVEY
 UNDER

G-1761	G-1608	32579
G-12714	G-11673	
R-80563	R-12123	
S-80564	S-52890	

Application No. _____ Permit No. _____ Certificate No. _____

A & R SPADA FARMS

SEPTEMBER 14, 1999
 SCALE: 1" = 1320'

NOTE: This map is for the purpose of identifying the location of water rights and has no intent to dimension or locate property ownership lines.

