


CLAIM OF BENEFICIAL USE MAP
TRANSFER T-9397
FOR
RICE HILL OWNERS ASSOCIATION
MR. GARY HALL, PRESIDENT
2391 TERRI DRIVE
MEDFORD, OREGON 97504
SITUATED IN
DONATION LAND CLAIM No. 47
SECTIONS 27 AND 28
TOWNSHIP 23 SOUTH, RANGE 5 WEST, W.M.
DOUGLAS COUNTY, OREGON

SOURCE

Rice Hill Owners Association Place of Use		
Tax Lot	Map No.	Acreage
100	23-05W-28D	2.27 Acres
200	23-05W-28D	10.44 Acres
1400	23-05W-28D	0.18 Acres
1402	23-05W-28D	1.54 Acres
1403	23-05W-28D	0.13 Acres
1404	23-05W-28D	0.41 Acres
1405	23-05W-28D	0.49 Acres
1600	23-05W-28D	0.34 Acres
1700	23-05W-28D	0.38 Acres
1800	23-05W-28D	0.40 Acres
		16.58 Acres
Acreage From Douglas County Tax Assessor Records		

- Well No. 1 Location
North 879.0 ft. & West 318.0 ft.
From The Southeast Cor. of
DLC No. 47, T23S, R5W, WM
- Well No. 2 Location
North 603.0 ft. & West 333.0 ft.
From The Southeast Cor. of
DLC No. 47, T23S, R5W, WM
- Well No. 3 Location
North 186.3 ft. & West 318.7 ft.
From The Southeast Cor. of
DLC No. 47, T23S, R5W, WM
- Well No. 4 Location
North 484.0 ft. & West 344.0 ft.
From The Southeast Cor. of
DLC No. 47, T23S, R5W, WM

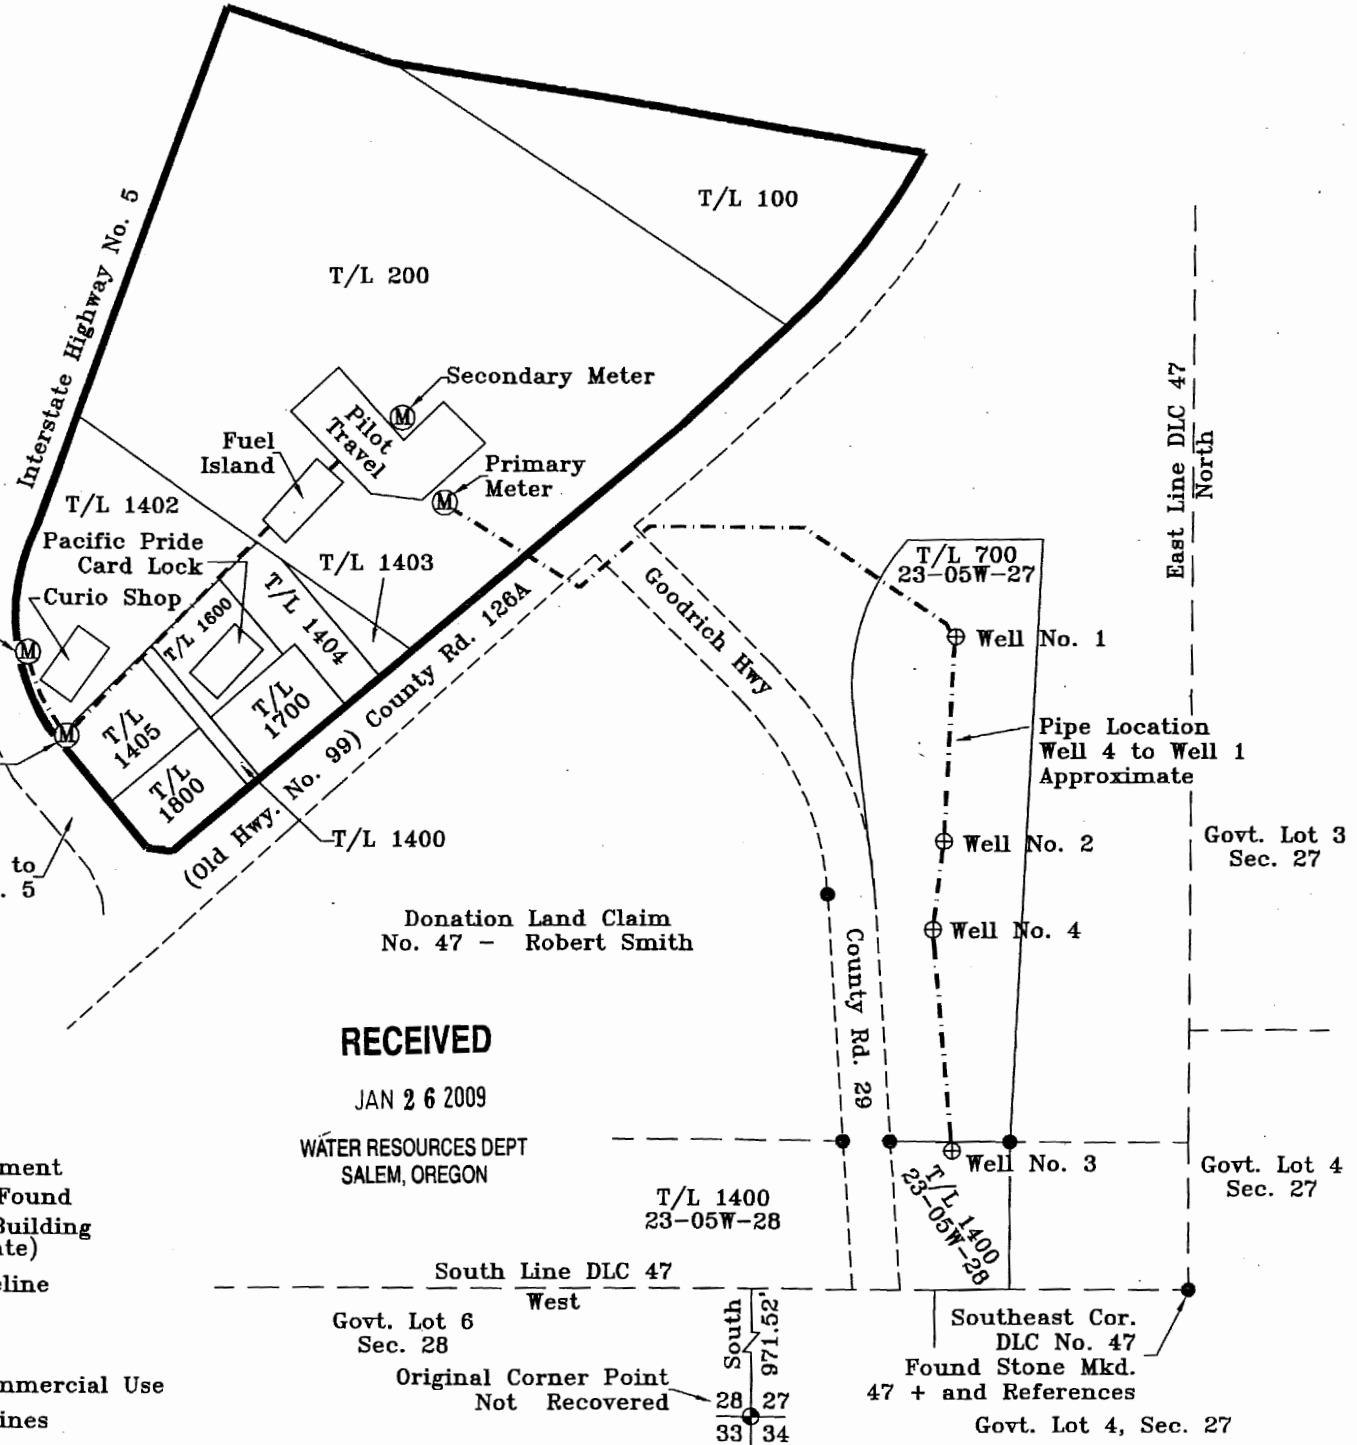


This map was prepared for the purpose of identifying the location of a water right only and is not intended to provide legal dimensions or location of property ownership.



Scale: 1"=200'

LEGEND

- Found Survey Monument
- ⊙ Survey Corner Not Found
- Denotes Structure/Building (Location Approximate)
- - - Denotes Buried Pipeline
- Ⓜ Denotes Flow Meter
- ⊕ Denotes Well
- ▬ Denotes Area of Commercial Use
- - - Denotes Projected Lines

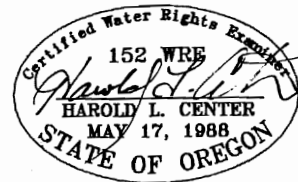

HAROLD L. CENTER
2604 David Lane
Medford, OR. 97504
Phone 541-535-6108
Oregon Certificate No. 152
Cert. Renewal Date: 12/31/2009

RECEIVED

JAN 26 2009

WATER RESOURCES DEPT
SALEM, OREGON

Govt. Lot 6
Sec. 28

Original Corner Point
Not Recovered

South
971.52'
28
27
33
34

Govt. Lot 4
Sec. 27

Southeast Cor.
DLC No. 47
Found Stone Mkd.
47 + and References
Govt. Lot 4, Sec. 27