


# T. 29S., R. 4W., W.M. SECTION 23

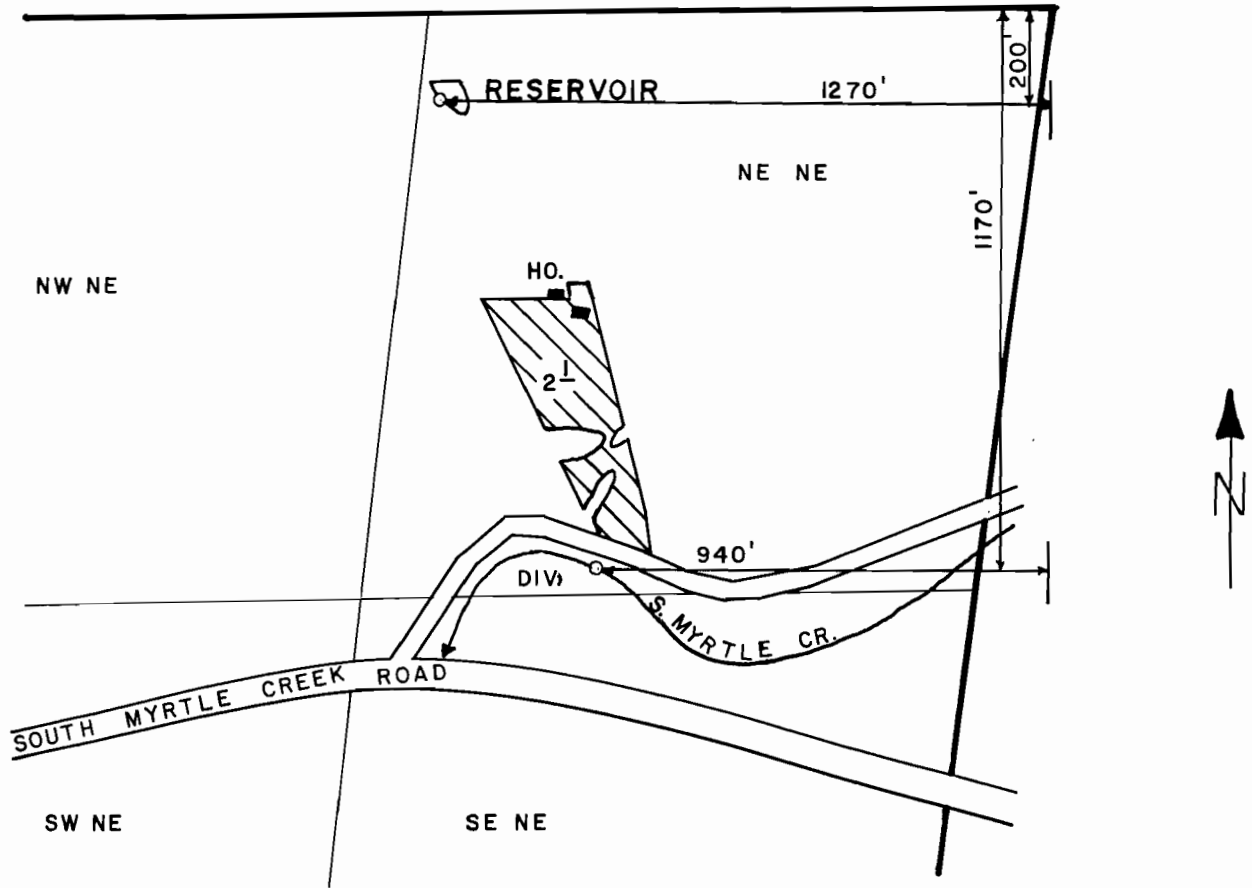

SCALE: 1" = 400'

## FINAL PROOF SURVEY UNDER

R-57654	R-7806
58085	43980
Application No. 54874	Permit No. 41160

IN NAME OF

**FRANCES M. SPENCER**

Surveyed MAY 16 1986, by J. M. SCHMORDE