



THIS MAP WAS PREPARED FOR THE PURPOSE OF IDENTIFYING THE LOCATION OF THE WATER RIGHT AND IS NOT INTENDED TO PROVIDE LEGAL DIMENSIONS OR LOCATIONS OF PROPERTY OWNERSHIP LINES.

T10S; R12,13E

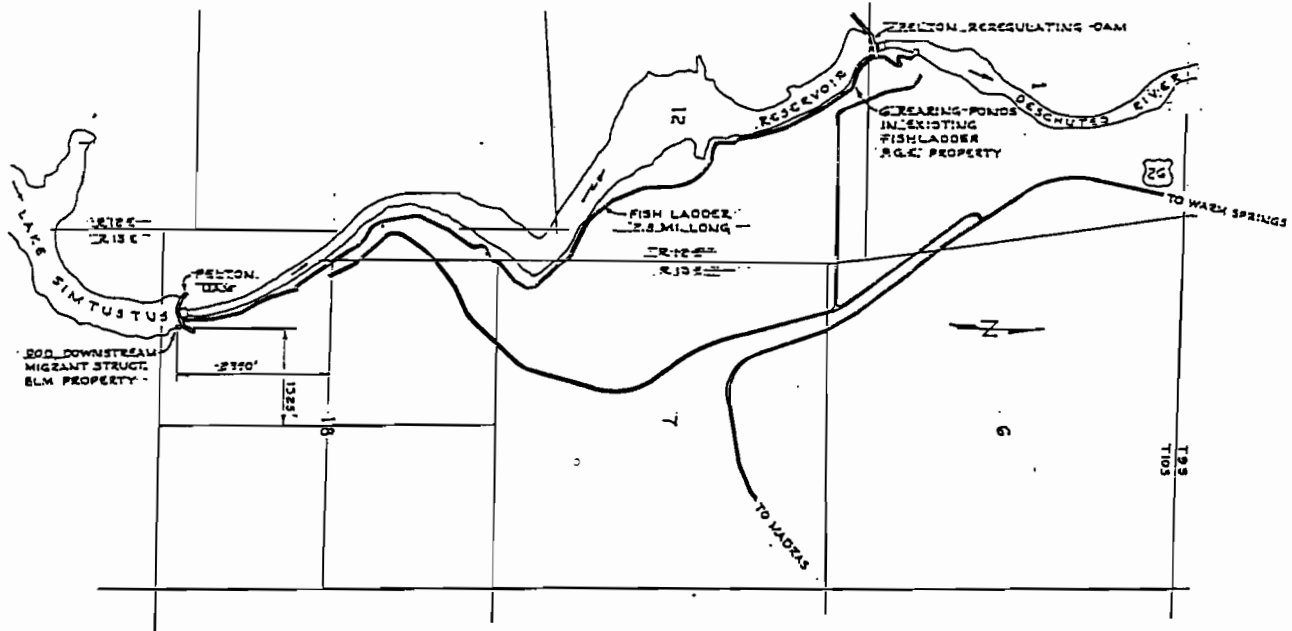

SCALE 1" = $\frac{300'}{3000'}$

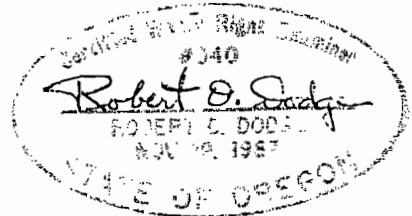

**FINAL PROOF SURVEY
UNDER**

APPLICATION NO. 5-72237 PERMIT NO. 52645
IN NAME OF

OREGON DEPARTMENT OF FISH AND WILDLIFE

SURVEYED: 11/6/96 BY: DODGE

HC WRD