


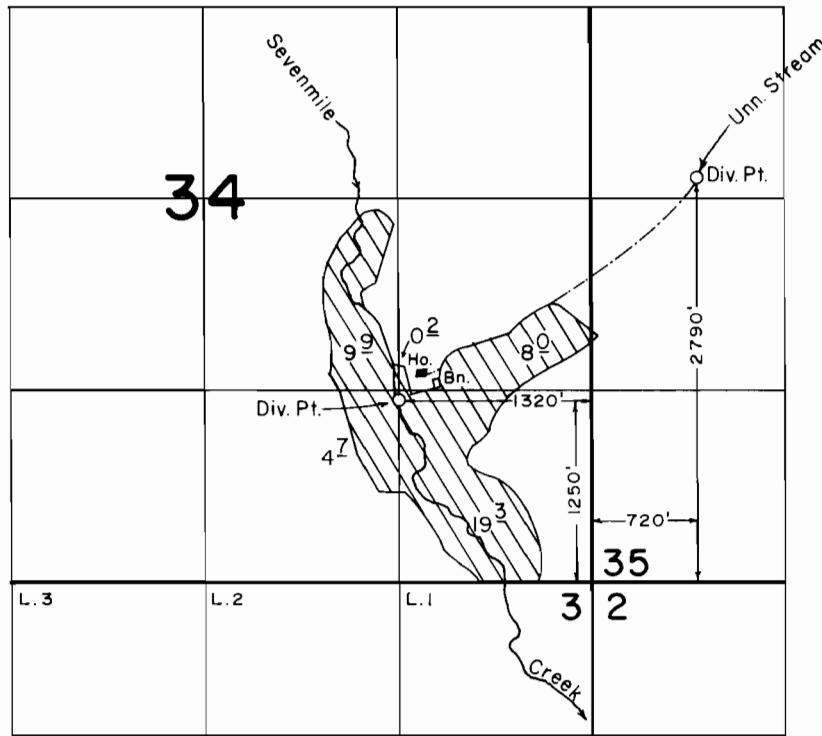

T. 27 S., R. 14 W., W.M.



SCALE: 1" = 1320'

FINAL PROOF SURVEY
UNDER

Application No. 53413 Permit No. 39867
IN NAME OF

JIM & SUSAN L. DEATHERAGE

Surveyed SEPT. 19 1989, by B. S. JAMES