


T. 14 S., R. 39 E., W.M.

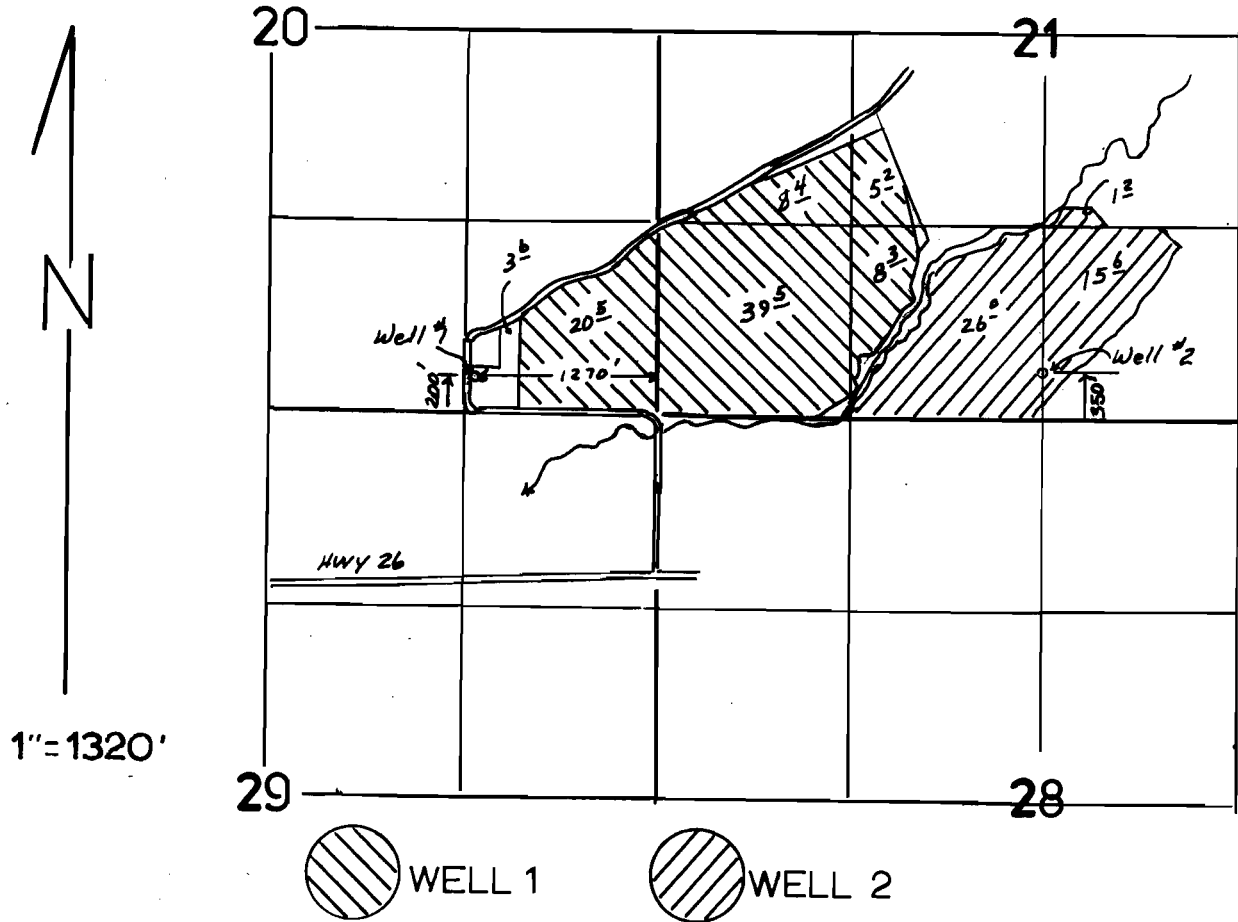

FINAL PROOF SURVEY
UNDER

Application No. G-11669 Permit No. G-10941
IN NAME OF

JOHN MOLTHAN

Surveyed JULY 6, 1994, by J. MILLER