


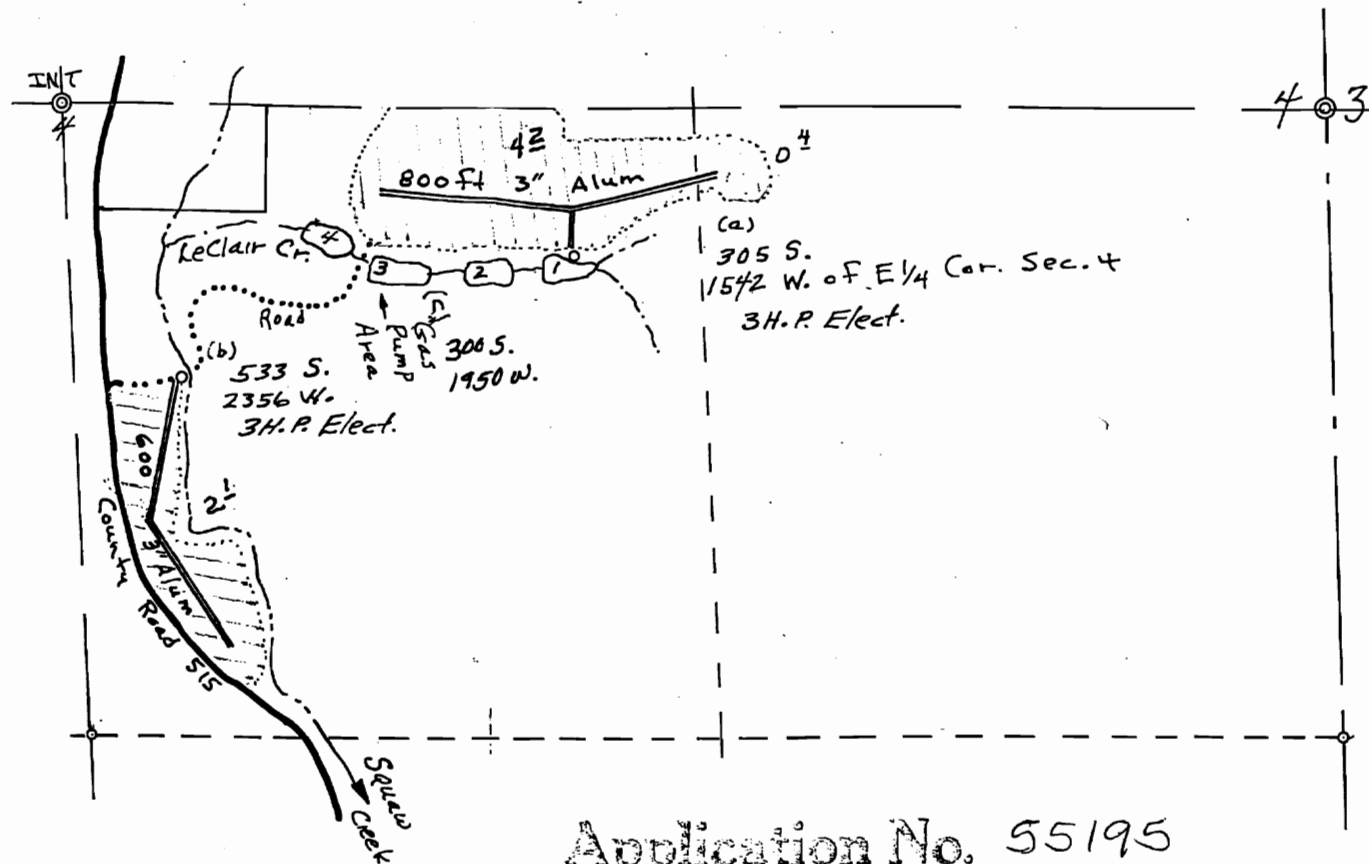

Application No. 55195
Permit No. 41406

WATER FILING FOR
JAMES W. LECLAIR
IN N $\frac{1}{2}$ SE $\frac{1}{4}$ SEC. 4, T.36S. R.14 W.
W.M., CURRY CO., ORE.
Scale 1" = 400 ft Jan. 1977
AMENDED 3/23/07 OWRD-LN

REGISTERED
PROFESSIONAL
LAND SURVEYOR

H. J. Newhouse

OREGON
MAY 10, 1957
H. J. NEWHOUSE
402