


Township 8 South, Range 25 East, W.M.

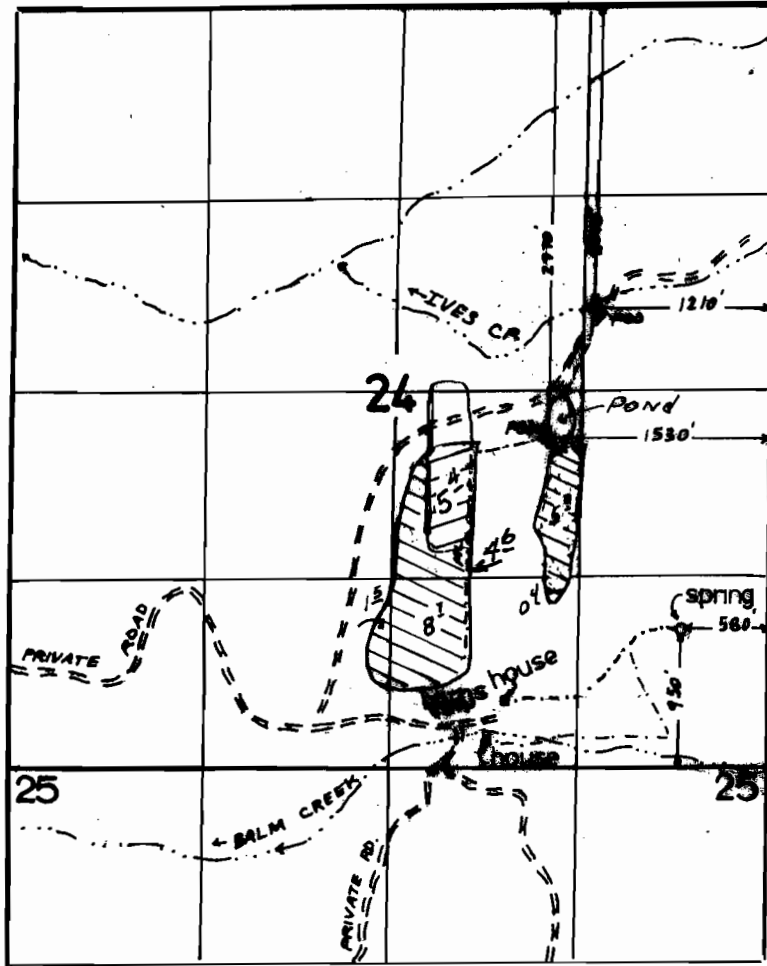

IVES CR. AND STORAGE FROM RES. P# 8799



STORAGE FROM RES. P# 8799

**FINAL PROOF SURVEY**  
**UNDER**

R 65076                      R 8799

. 65077                      47608

Application No. ...69153. Permit No. ...50110....

**IN NAME OF**

.....KARL..H..AND..HELGA..G..MOLL.....

Surveyed ..7.-18..... 2000., by ..J.MILLER.....