


Township 8 South, Range 25 East, W.M.

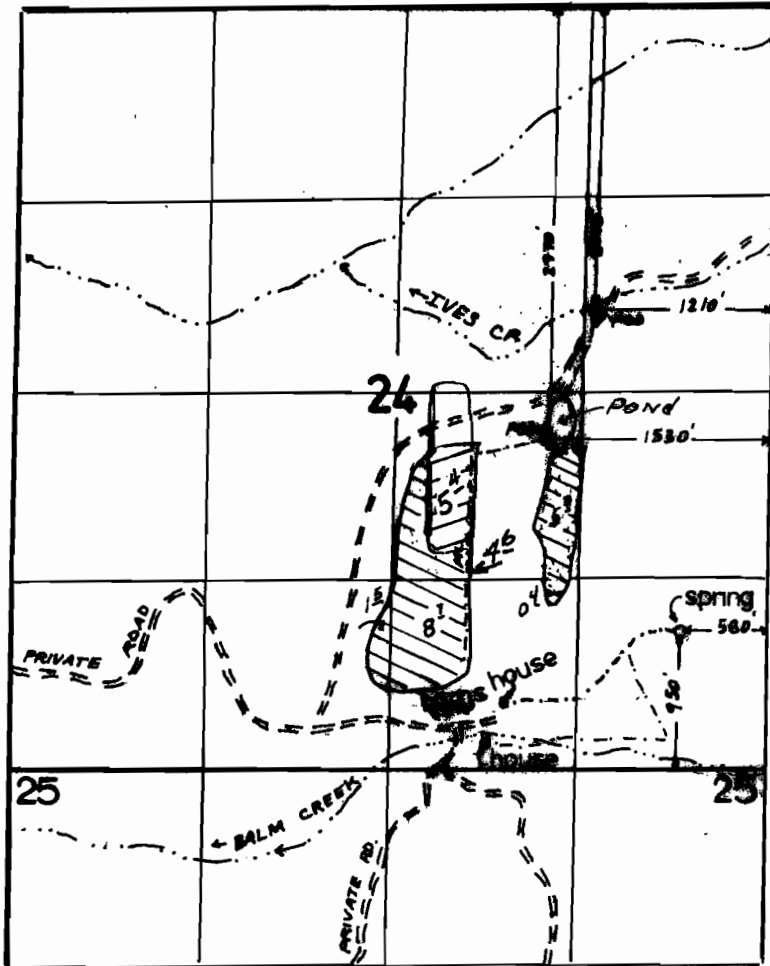

IVES CR. AND STORAGE FROM RES. P# 8799



STORAGE FROM RES. P# 8799

**FINAL PROOF SURVEY
UNDER**

R 65076 R 8799

.65077 47608

Application No. ...69153. Permit No. ...50110....

IN NAME OF

.....KARL H. AND HELGA G. MOLL.....

Surveyed 7-18..... 2000, by J. MILLER.....