


RECEIVED

SEP 29 2007

WATER RESOURCES DEPT
SALEM, OREGON

Claim of Beneficial Use Map

Permit S-47675 (Application S-65054)
Section 8, Township 2 South, Range 4 East (W.M.)

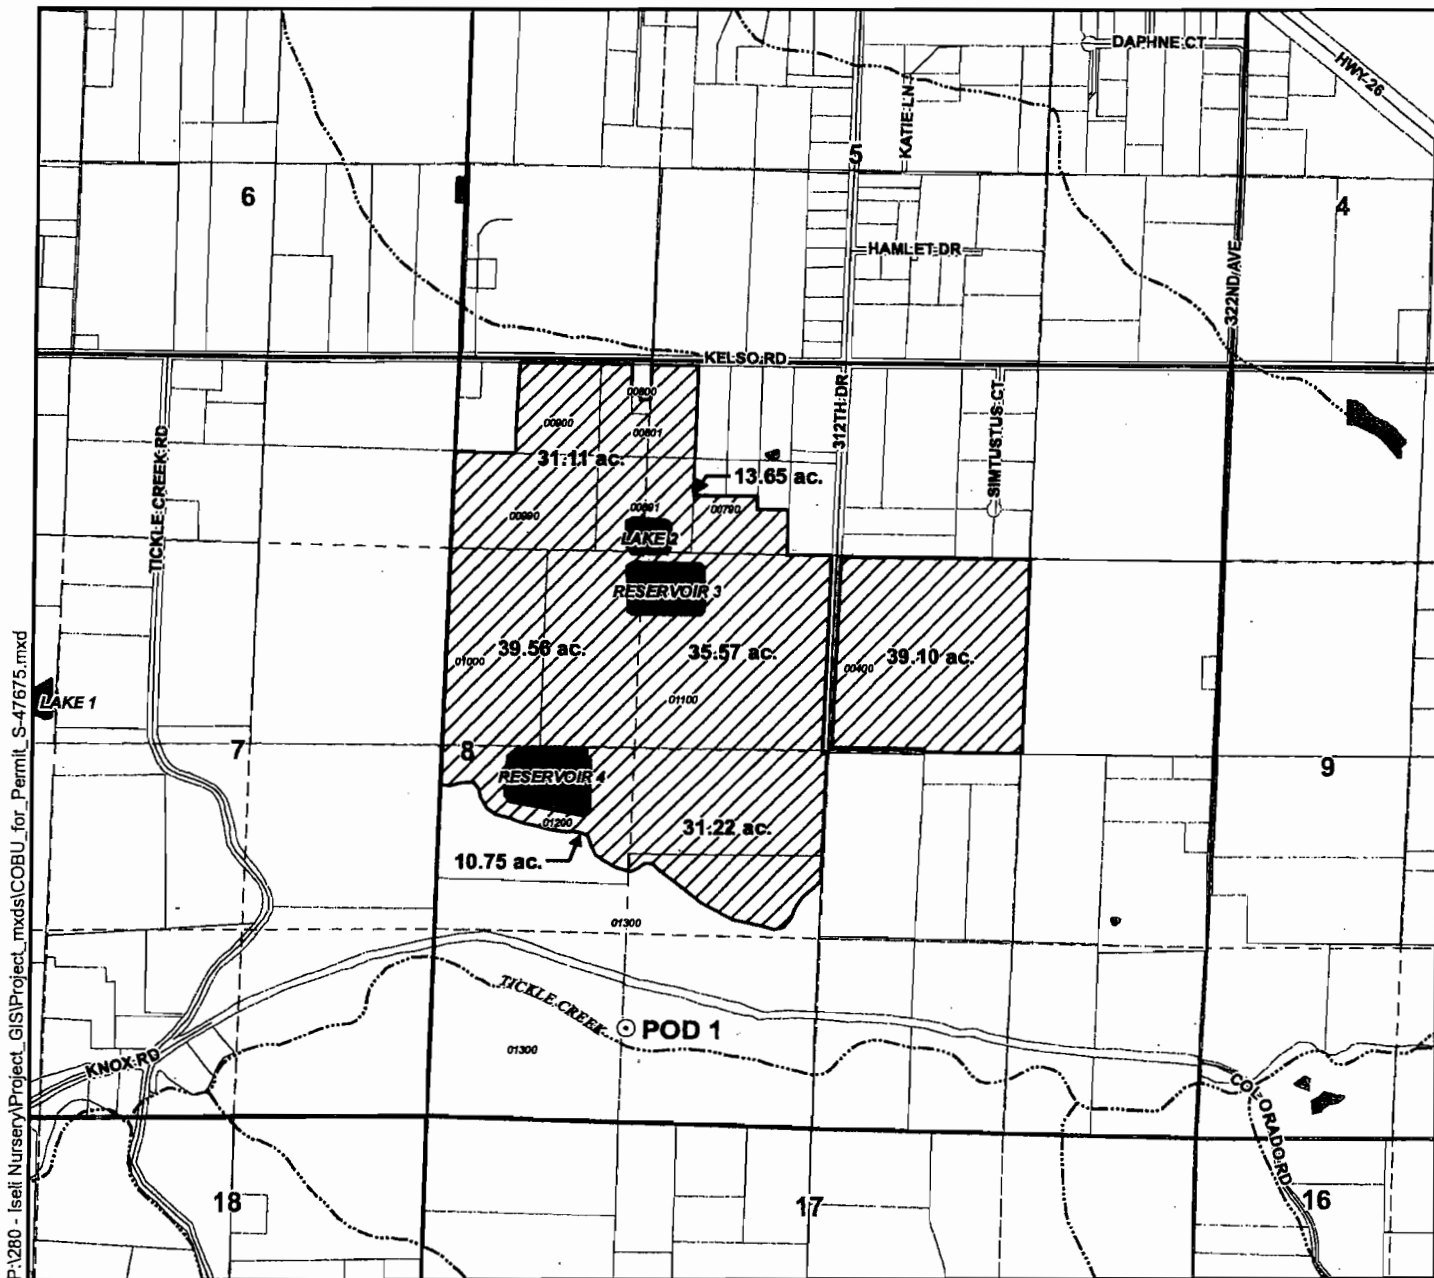


P:\280 - Iselt Nursery\Project_GIS\Project_mxd\COBU_for_Permit_S-47675.mxd

Legend

- Point of Diversion (POD)
- ▨ Place of Use (POU)
- ⊕ Tax Lots
- Roads
- ~ Watercourses
- ◼ Waterbodies

POD Location Description

POD 1
Located 645 feet North and 1,345 feet East from the SW corner of Section 8, Township 2 South, Range 4 East (W.M.)

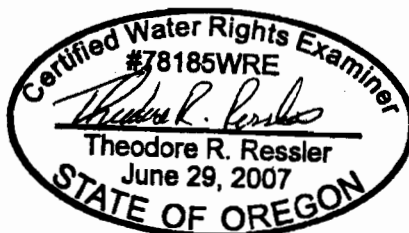

EXPIRES: 12-31-2008

RECEIVED

SEP 29 2007

WATER RESOURCES DEPT
SALEM, OREGON

Map Information

Projection: Oregon State Plane North Zone
Datum: North American Datum of 1983
Date: August 11, 2008
Prepared By: GSI Water Solutions, Inc.

Data Sources

Clackamas County GIS, Oregon Geospatial Data Clearinghouse

Disclaimer

This map was prepared for the purpose of identifying the location of a water right only and it is not intended to provide legal dimensions or location of property ownership lines.



Scale

0 660 1,320
1 inch equals 1,320 feet

