


# Claim of Beneficial Use Map

Permit S-50048 (Application S-69176)

Section 8, Township 2 South, Range 4 East (W.M.)

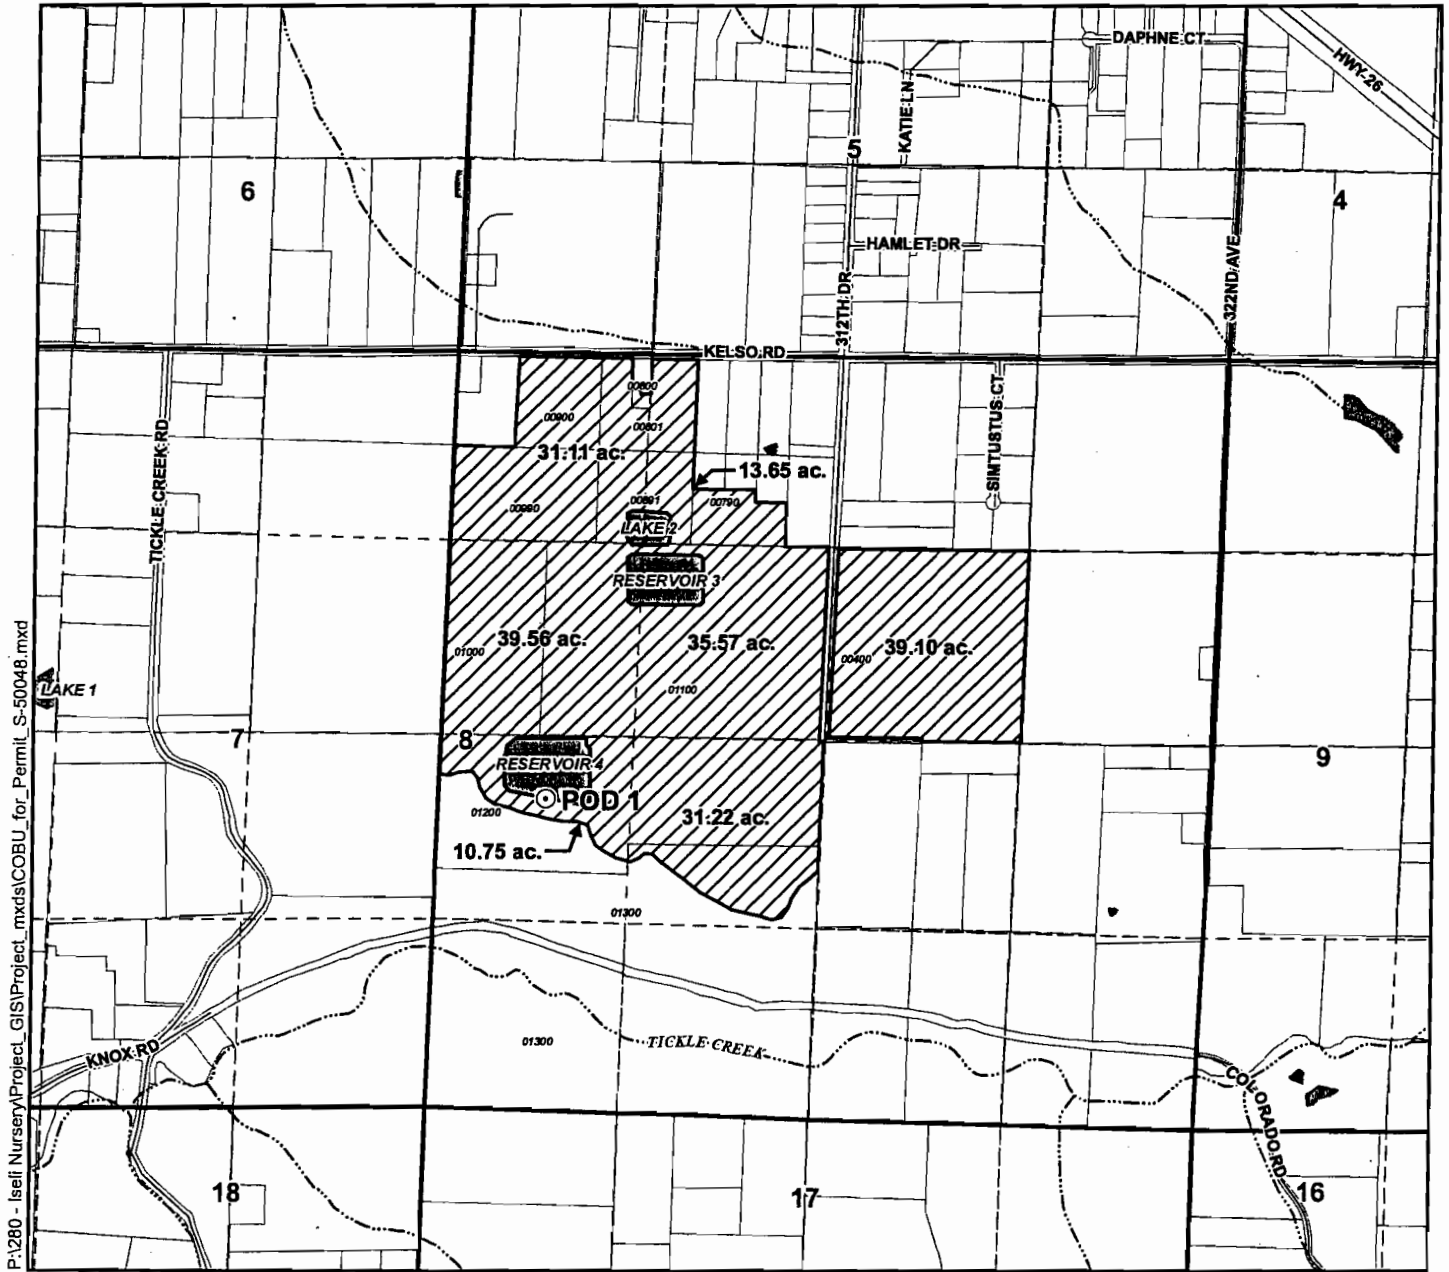


P:\280 - Isel Nursery\Project\_GIS\Project\_mxd\COBU\_for\_Permit\_S-50048.mxd

## Legend

- ⊙ Point of Diversion (POD)
- ▨ Place of Use (POU)
- ⊕ Tax Lots
- Roads
- ~ Watercourses
- ◼ Waterbodies

## POD Location Description

POD 1  
 Located 2,140 feet North and 730 feet East from the SW corner of Section 8, Township 2 South, Range 4 East (W.M.)

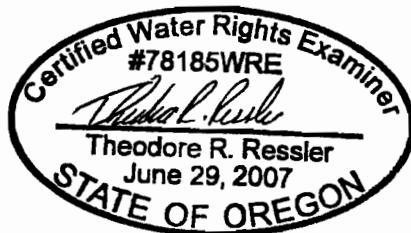

EXPIRES: 12-31-2008

## Map Information

Projection: Oregon State Plane North Zone  
 Datum: North American Datum of 1983  
 Date: August 11, 2008  
 Prepared By: GSI Water Solutions, Inc.

## Data Sources

Clackamas County GIS, Oregon Geospatial Data Clearinghouse

## Disclaimer

This map was prepared for the purpose of identifying the location of a water right only and it is not intended to provide legal dimensions or location of property ownership lines.

RECEIVED

P 29 2008

WATER RESOURCES DEPT  
 SALEM OREGON



## Scale

0 660 1,320  
 1 inch equals 1,320 feet

