


T. 38 S, R. 2 W., W.M.

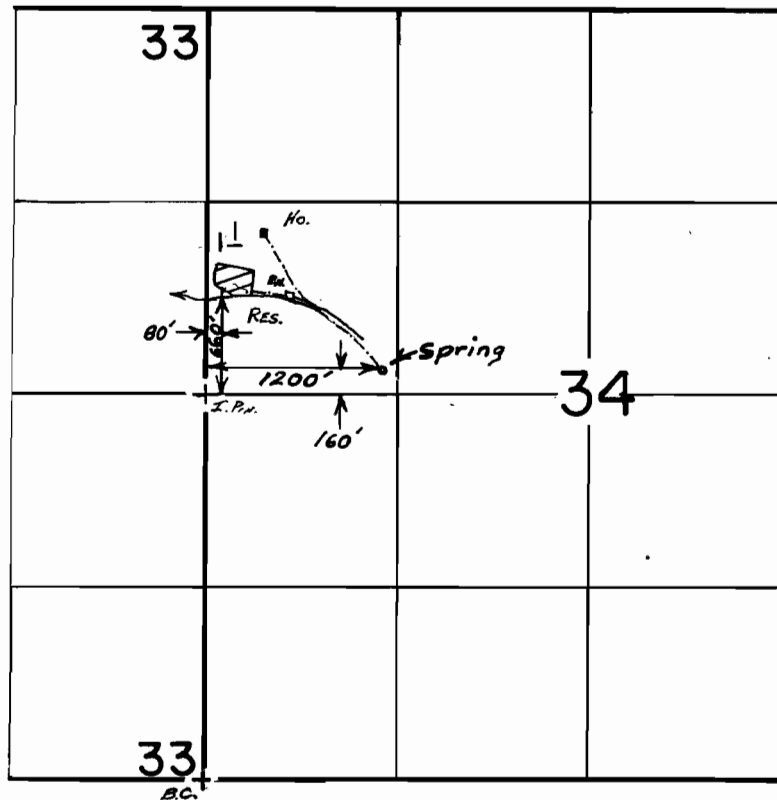

Scale : 1" = 1320'

FINAL PROOF SURVEY
UNDER

R-53903 R-6439
Application No. ~~53904~~ Permit No. ~~40397~~.....
IN NAME OF

.....JAMES.....E.....PERKINS.....

Surveyed March 30, 1993., by S. DeHaas.....