


T. 38 S., R. 2 W., W.M.

RECORDED

INDEXED
MAY 10 1893

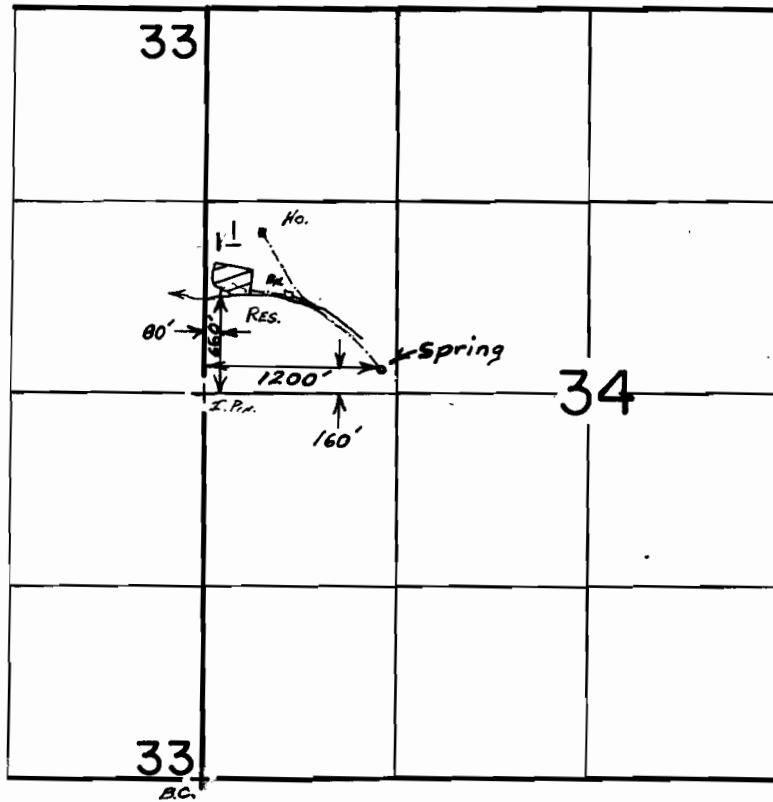

Scale : 1" = 1320'

FINAL PROOF SURVEY
UNDER

R-53903 R-6439

Application No. ~~53904~~ Permit No. 40397.....

IN NAME OF

.....JAMES.....E.....PERKINS.....

Surveyed March 30, 1993., by S. DeHaas.....