


T.1N., R.12E., W.M.

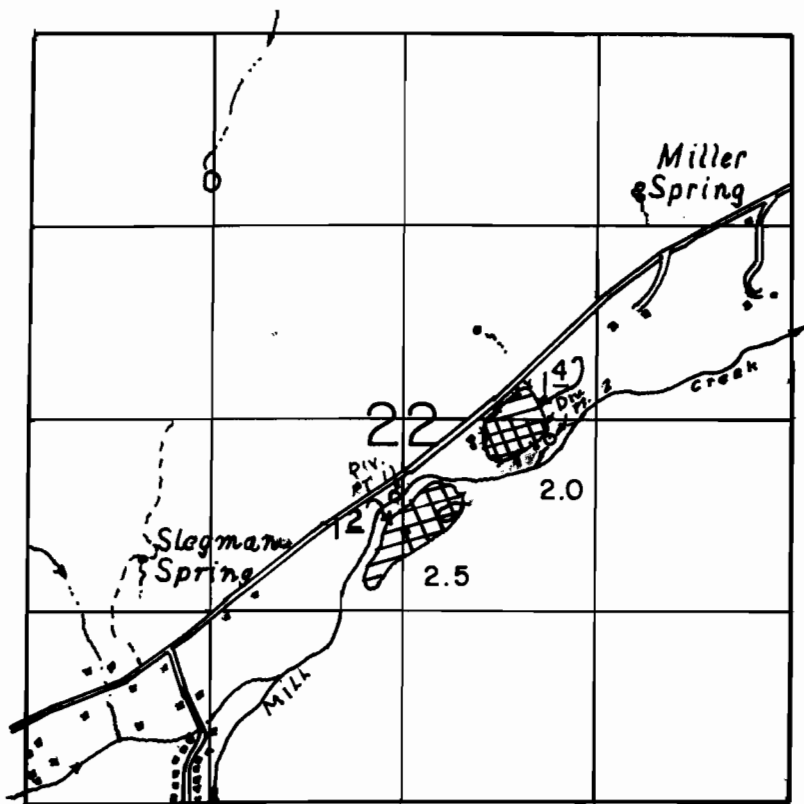

DIV. PT. LOC: 2480' N & 3570' E FROM SW COR OF SEC 22.
 2070' N & 2520' E FROM SW COR OF SEC 22

SCALE: 1" = 1320'

FINAL PROOF SURVEY

UNDER

 PRIMARY
 SUPPLEMENTAL

TRANSFER NO. 3670
 Application No. ~~55888~~ Permit No. ~~42251~~....
 IN NAME OF

.....MICHAEL T. PETERSON.....

Surveyed MAY 17, 1995, by R.M. SUTTERFIELD