


T.1N., R.12E., W.M.

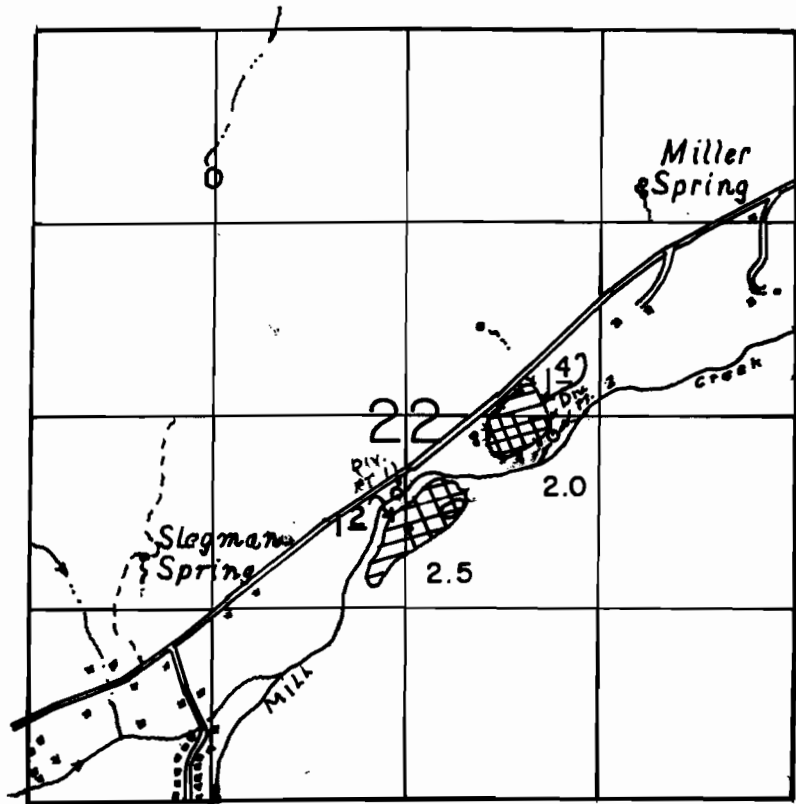

DIV. PT. LOC: 2480' N & 3570' E FROM SW COR OF SEC 22.
2070' N & 2520' E FROM SW COR OF SEC 22

SCALE: 1" = 1320'

FINAL PROOF SURVEY

UNDER

- PRIMARY
- SUPPLEMENTAL

TRANSFER NO. 3670
Application No. 55888 Permit No. 42251....
IN NAME OF

.....MICHAEL T. PETERSON.....

Surveyed MAY 17, 1995, by R.M. SUTTERFIELD