

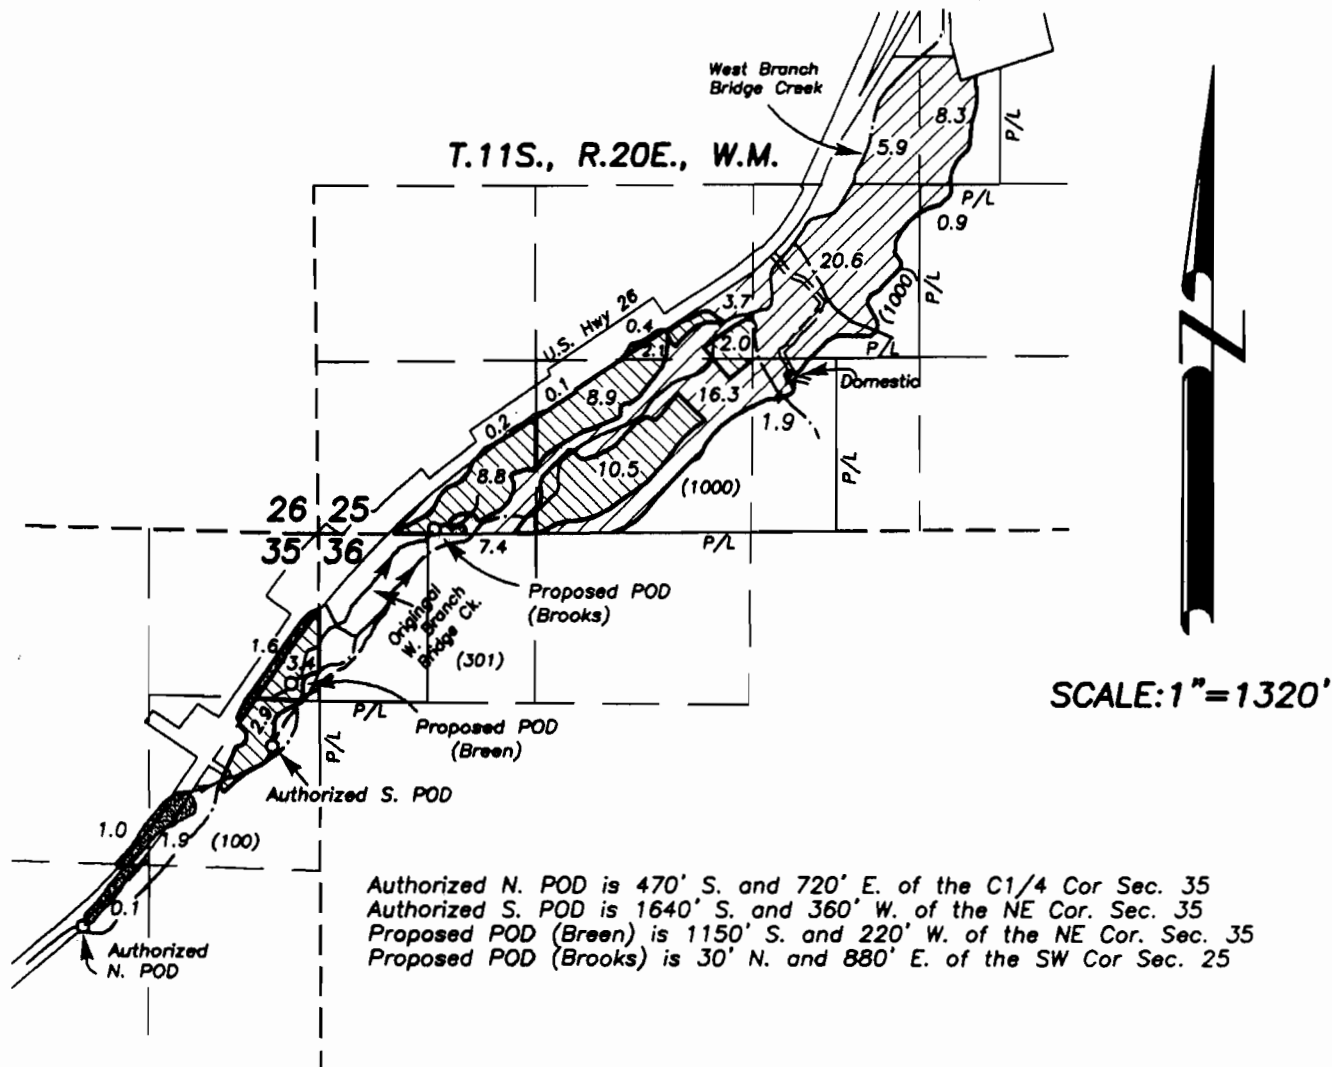
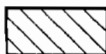


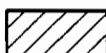

-  CERT 56516
-  PERMIT 47328
-  LANDS NOT AFFECTED
- P/L PROPERTY LINE
- () TAX LOT NO.

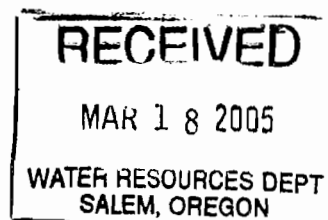

APPLICATION MAP FOR ADDITIONAL POINT OF DIVERSION

FOR


JAMES BROOKS
AND
MICHAEL BREEN

BY

BAGETT, GRIFFITH & BLACKMAN
217 N. CANYON BLVD.
JOHN DAY, OR. 97845
(541) 575-1251

DECEMBER 7, 2004

NOTE: The preparation of this map was for the purpose of identifying the location of the proposed water right and has no intent to provide dimensions or location of property ownership lines.

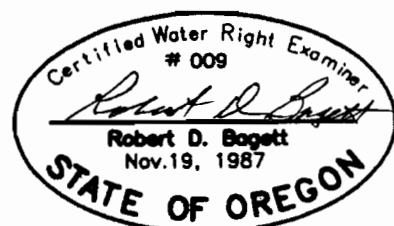

T-9891